

SURVEY & REMONUMENTATION

JAN 19 1999

SECTION

LAND CORNER RECORDATION CERTIFICATE
Filing Requirement of Act 74, Mich. P.A. 1970

for corners in

<u>Iron</u> (County)	Located In:	Corner Code #
1. Public Land Survey	T <u>42N</u> R <u>34W</u>	<u>A-4</u>
	T <u>42N</u> R <u>35W</u>	<u>M-4</u> ✓
	T _____ R _____	_____
	T _____ R _____	_____
2. Property Controlling in Section	S _____ T _____ R _____	_____
	S _____ T _____ R _____	_____
3. Miscellaneous Property in Sec.	S _____ T _____ R _____	_____
	S _____ T _____ R _____	_____

IRON COUNTY
MICHIGAN
RECEIVED FOR RECORD

98 DEC 28 AM 11:30
L.C. Records: L. 7, P. 338

Gary L. Pisoni
REGISTERED LAND SURVEYOR

Register of Deeds Stamp & File Number

4. Lot No. _____, Recorded Plat _____
5. Private Claims _____

Quarter Corner Section 12, T42N, R35W
Quarter Corner Section 7, T42N, R34W

I, Gary L. Pisoni, in a field survey on Dec. 16, 1998 do hereby state that under requirements of P.A. 74, Michigan P.A. of 1970, the corner points mentioned in lines 1 and 2 above were in conformance with regulations and rules therefore as required in the current manual of survey instructions of the United States Department of the Interior, Bureau of Land Management or by a decree of a Court of Law and /or that the corner points mentioned in lines 3, 4 and 5 above were in conformance with the rules of the Michigan Board of Land Surveyors or by a Decree of a Court of Law; established, re-established, monumented, recovered, found as expressed below:

NOTE: Not more than 2 corners, all in the same town and range, may be recorded on this certificate.

	A	B	C	D	E	F	G	H	I	J	K	L	M
1													
2		6		5		4		3		2		1	
3													
4	●	7		8		9		10		11		12	●
5													
6		18		17		16		15		14		13	
7													
8		19		20		21		22		23		24	
9													
10		30		29		28		27		26		25	
11													
12		31		32		33		34		35		36	
13													

A. Description of original monument and accessories and/or subsequent restoration:

Original corner established in 1846, by William A. Burt, U.S. Deputy Surveyor.
Original Corner: Ironwood Post
Original Bearing Trees:

Yellow Birch	14"	N 59° E	20 links (13.20 feet)
Lynn	10"	S 63° W	19 links (12.54 feet)

PEER GROUP APPROVED
Iron A. Pisoni 12-18-98
COUNTY REPRESENTATIVE

B. Description of corner evidence found and/or method applied in restoring or reestablishing corner:

No evidence of original B.T.s found. Found a 2" diameter iron pipe marking corner position and located on an old fence line. Iron pipe set by unknown persons and has been in existence for over 40 years. I accept the iron pipe as the best available evidence for restoring the corner position.


Corner record research on file with County Representative.

C. Description of monument for corner and accessories established to perpetuate locating the position of the corner:

At the above described corner position, I set a 5/8" diameter by 30" long rebar pin in the center of the iron pipe and placed a 3" diameter aluminum cap over the top of the rebar pin and stamped as follows:
Iron County Remonumentation, T42N, R35W, R34W, 1/4, S-12, S-7, 1998, RLS 27457, from which I established the following new blazed and scribed bearing trees: (All measurements taken to a nail in side of tree)

Sugar Maple	13"	N 44° E	54.11 feet
Balsam	6"	S 54° E	13.25 feet
Sugar Maple	11"	S 22° E	59.92 feet
White Birch	6"	S 44° W	27.35 feet
Steel sign post		East	0.88 feet

98-166
Signed by Gary L. Pisoni Date 12-21-98
Surveyor's Michigan License No. 27457

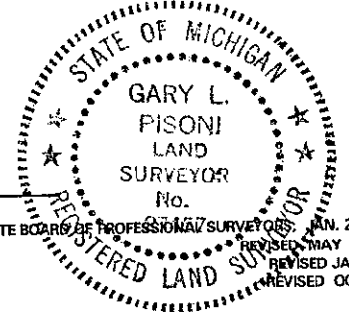

FORM APPROVED BY MICHIGAN STATE BOARD OF PROFESSIONAL SURVEYORS, JAN. 28, 1971
REVISED MAY 14, 1975
REVISED JAN., 1983
REVISED OCT., 1995

L. 7 P. 338