

REL

MAR 09 2000

SECTION

LAND CORNER RECORDATION CERTIFICATE
Filing Requirement of Act 74, Mich. P.A. 1970

For corners in

Form with fields for County (Iron), Located In (T. 42N R. 35W), Corner Code # (M-6), and numbered sections 1-5 for survey details.

IRON COUNTY MICHIGAN RECEIVED FOR RECORD

99 DEC 30 AM 10:28
L.C. Records: L.S. P. 107
[Signature]

Register of Deeds Stamp & File Number

4. Lot No. , Recorded Plat
5. Private Claims

Quarter Corner to Section 13, T42N, R35W
Quarter Corner to Section 18, T42N, R34W

I, Gary L. Pisoni, in a field survey on Nov. 11, 1999 do hereby state that under requirements of P.A. 74, Michigan P.A. of 1970, the corner points mentioned in lines 1 and 2 above were in conformance with regulations and rules therefore as required in the current manual of survey instructions of the United States Department of the Interior, Bureau of Land Management or by a decree of a Court of Law and for that the corner points mentioned in lines 3, 4 and 5 above were in conformance with the rules of the Michigan Board of Land Surveyors or by a Decree of a Court of Law; established, re-established, monumented, recovered, found as expressed below:

NOTE: Not more than 2 corners, all in the same town and range, may be recorded on this certificate.

Grid table with columns A-M and rows 1-13, containing numerical values for survey points.

A. Description of original monument and accessories and/or subsequent restoration:

Original corner established in 1846 by William A. Burt, U.S. Deputy Surveyor. Original Corner; Fir Wood Post
Original Bearing Trees:
Fir 6" S 55° E 12 lks (7.92 feet)
White Pine 50" N 20° W 13 lks (8.58 feet)

PEER GROUP APPROVED
Iron County Rep. 12-31-99
COUNTY REPRESENTATIVE


B. Description of corner evidence found and/or method applied in restoring or reestablishing corner:

No evidence of original B.T.s found.
Restored the corner position by single proportionate measurement and on line between the Northeast and Southeast Section corners of Section 13, T42N, R35W.
Corner record research on file with County Representative.

C. Description of monument for corner and accessories established to perpetuate locating the position of the corner:

At the corner position, set a 2" diameter by 30" long split base aluminum pipe monument, with a 3" dia. aluminum cap stamped as follows: Iron County Remonumentation, T42N, R35W, R34W, 1/4, S-13, S-18, 1999, RLS 27457
from which I established the following new blazed and scribed bearing trees:(All measurements taken to a nail in side of tree)
White Spruce 7" N 41° E 7.05 feet
White Spruce 7" S 84° E 19.72 feet
White Spruce 10" S 02° E 14.09 feet
White Spruce 7" N 68° W 1.80 feet
Steel sign post East 0.65 feet

99-107
Signed by Gary L. Pisoni Date 12-28-99
Surveyor's Michigan License No. 27457

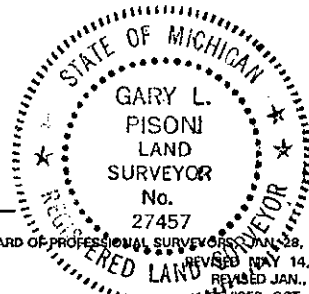

FORM APPROVED BY MICHIGAN STATE BOARD OF PROFESSIONAL SURVEYORS, JULY 28, 1971
REVISED MAY 14, 1975
REVISED JAN., 1983
REVISED OCT., 1995