

MAR 09 2000

SECTION

LAND CORNER RECORDATION CERTIFICATE
Filing Requirement of Act 74, Mich. P.A. 1970

For corners in

Iron	Located In:	Corner Code #
(County)		
1. Public Land Survey	T <u>42N</u> R <u>35W</u>	<u>M-8</u> ✓
	T <u>42N</u> R <u>34W</u>	<u>A-8</u>
	T _____ R _____	_____
	T _____ R _____	_____
2. Property Controlling in Section	S _____ T _____ R _____	_____
	S _____ T _____ R _____	_____
3. Miscellaneous Property in Sec.	S _____ T _____ R _____	_____
	S _____ T _____ R _____	_____

IRON COUNTY
MICHIGAN
RECEIVED FOR RECORD

99 DEC 30 AM 10:29
L.C. Records: L. 8, P. 109
Robert J. Stiehl
REGISTERED SURVEYOR

Register of Deeds Stamp & File Number

4. Lot No. _____, Recorded Plat _____
5. Private Claims _____

Quarter Corner to Section 24, T42N, R35W
Quarter Corner to Section 19, T42N, R34W

I, Gary L. Pisoni, in a field survey on Oct. 16, 1999 do hereby state that under requirements of P.A. 74, Michigan P.A. of 1970, the corner points mentioned in lines 1 and 2 above were in conformance with regulations and rules therefore as required in the current manual of survey instructions of the United States Department of the Interior, Bureau of Land Management or by a decree of a Court of Law and /or that the corner points mentioned in lines 3, 4 and 5 above were in conformance with the rules of the Michigan Board of Land Surveyors or by a Decree of a Court of Law; established, re-established, monumented, recovered, found as expressed below:

	A	B	C	D	E	F	G	H	I	J	K	L	M
1													
2	6		5		4		3		2		1		
3													
4	7		8		9		10		11		12		
5													
6	18		17		16		15		14		13		
7													
8	19		20		21		22		23		24		
9													
10	30		29		28		27		26		25		
11													
12	31		32		33		34		35		36		
13													

NOTE: Not more than 2 corners, all in the same town and range, may be recorded on this certificate.

A. Description of original monument and accessories and/or subsequent restoration:

Original corner established in 1846 by William A. Burt, U.S. Deputy Surveyor.
Original Corner; Cedar Wood Post
Original Bearing Trees:

Tamarack	6"	N 73° E	5 lks (3.30 feet)
Tamarack	14"	S 50° W	6 lks (3.96 feet)

PEER GROUP APPROVED

Iron Gary L. Pisoni 12-21-99
COUNTY REPRESENTATIVE

B. Description of corner evidence found and/or method applied in restoring or reestablishing corner:

No evidence of original B.T.s found.


At the corner position, found a 3/4" diameter iron pipe located 1' East of a fence corner, said fence running North and South and West. Iron pipe was set by W. E. DeWald, a local mining engineer, in the 1960's. Iron pipe is consistent with GLO distances North and South. I accept the iron pipe as the best available evidence for restoring the corner position.

Corner record research on file with County Representative.

C. Description of monument for corner and accessories established to perpetuate locating the position of the corner:

Inside the iron pipe, set a 5/8" diameter by 30" long rebar with a 3" diameter aluminum cap stamped as follows: Iron County Remonumentation, T42N, R35W, R34W, 1/4, S-24, S-19, 1999, RLS 27457 from which I established the following new blazed and scribed bearing trees: (All measurements taken to a nail in side of tree)

Tamarack	11"	N 51° E	13.70 feet
Tamarack	9"	S 40° E	15.34 feet
Tamarack	9"	S 57° W	8.21 feet
Tamarack	8"	N 14° W	33.98 feet
Steel sign post		West	0.62 feet

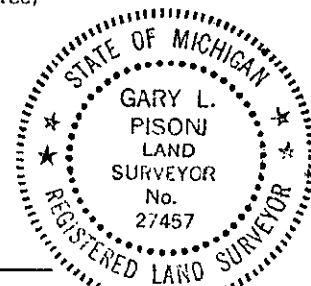

99-109
Signed by Gary L. Pisoni Date 12-28-99

Surveyor's Michigan License No. 27457