SURVEY & MONUMENTATION
FEB 22 1996
COMMISSION

LAND CORNER RECORDATION CERTIFICATE

Filing Requirement of Act 74, Mich. P.A. 1970

For corners in Iron (County)

	Located in:	Corner Code ##
1. Public Land Survey	T 43N R 35W	J-13
	T 42N R 35W	J-1
	T ___ R ___	
	T ___ R ___	
2. Property Controlling	S ___ T ___ R ___	
in Section	S ___ T ___ R ___	
3. Miscellaneous	S ___ T ___ R ___	
Property in Sec.	S ___ T ___ R ___	

REGISTER'S OFFICE) SS
IRON COUNTY, MICH.)
RECEIVED FOR RECORD THE 21ST DAY OF FEBRUARY A.D. 19 95 AT 2:45 O'CLOCK P M., AND RECORDED IN LIBER 6 OF LC RECORDS ON PAGE 373
Mark Sellers
DEPUTY REGISTER OF DEEDS

Register of Deeds Stamp & File Number

4. Lot No. _____, Recorded Plat _____
5. Private Claims _____

Quarter Corner 35, 2, T43N T42N R35W

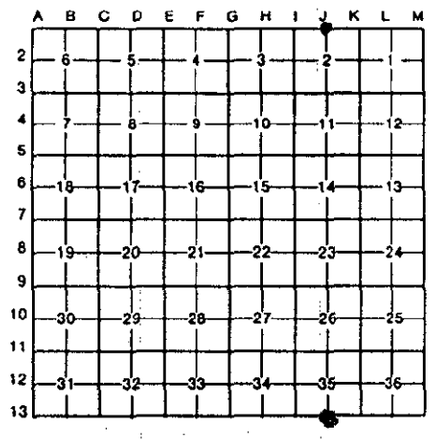

I, Gary L. Pisoni, in a field survey on October 24, 19 94, do hereby certify that under requirements of P.A. 74, Michigan P.A. of 1970, the corner points mentioned in lines 1 and 2 above were in conformance with regulations and rules therefore as required in the current manual of survey instructions of the United States Department of the Interior, Bureau of Land Management or by a decree of a Court of Law and/or that the corner points mentioned in lines 3, 4 and 5 above were in conformance with the rules of the Michigan Board of Land Surveyors or by a Decree of a Court of Law; established, re-established, monumented, re-monumented, recovered, found as expressed below:

NOTE: Not more than 4 corners, all in the same town and range, may be recorded on this certificate.

A. Description of original monument and accessories and/or subsequent restoration:

Original corner established by Austin Burt, U.S. Deputy Surveyor in 1846.
Original corner: Hemlock Post
Original bearing trees:

Spruce	7"	N 11°E	29 links (19.14 feet)
Yellow Birch	18"	N 26°W	8 links (5.28 feet)

B. Description of corner evidence found and/or method applied in restoring or reestablishing corner:

No evidence of original corner or bearing tree remains. Corner position found marked by a large spike and located in the centerline of an East/West county road and in line with a wire fence line running South. Corner position has been used and accepted as the corner locally for many years. Set an aluminum pipe monument 6" below road bed surface as described below.

This corner is accepted as the best available evidence of the position of the original corner.

County Record Research on file with County Representative office.

PEER GROUP APPROVED
Iron Gary L. Pisoni
COUNTY, REPRESENTATIVE
A.P. 11-30-94

C. Description of monument for corner and accessories established to perpetuate locating the position of the corner:

At the corner position, I set a 2" diameter by 30" long split base aluminum pipe monument with a 3" cast aluminum cap, stamped to read: Iron County Remonumentation, T43N, R35W, 1/4, S-35, S-2, T42N, 1994, RLS- 27457 from which I established the following new blazed and scribed bearing trees: (all measurements taken to a nail in side of tree)

Utility Pole		N 55°E	47.92 feet
Cherry	6"	S 07°E	35.32 feet
Red Maple	7"	S 55°W	75.17 feet
Utility Pole		N 70°W	82.51 feet
Steel Sign Post		North	21.13 feet

STATE OF MICHIGAN GARY L. PISONI LAND SURVEYOR No. 27457 REGISTERED LAND SURVEYOR

Signed by Gary L. Pisoni Date 1-9-95

Surveyor's Michigan License No. 27457

FORM APPROVED BY MICHIGAN STATE BOARD OF LAND SURVEYORS JAN. 28, 1971 REVISED MAY 14, 1975 REVISED JAN., 1983