

LAND CORNER RECORDATION CERTIFICATE
Filing Requirement of Act 74, Mich. P.A. 1970 as Amended

For corners in

Iron	Located In:	Corner Code #
(County)		
1. Public Land Survey	T <u>42N</u> R <u>35W</u>	<u>E8</u>
	T <u>42N</u> R <u>35W</u>	<u>C7</u>
	T _____ R _____	_____
	S _____ T _____ R _____	_____
2. Property Controlling in Section	S _____ T _____ R _____	_____
	S _____ T _____ R _____	_____
3. Miscellaneous Property in Sec.	S _____ T _____ R _____	_____
	S _____ T _____ R _____	_____

Register of Deeds Stamp & File Number

4. Lot No. _____, Recorded Plat _____
 5. Private Claims

C7 May 25 2006
 E8 May 17 2006

A	B	C	D	E	F	G	H	I	J	K	L	M
1												
2	6		5		4		3		2		1	
3												
4	7		8		9		10		11		12	
5												
6	18		17		16		15		14		13	
7		●										
8	19		20	●	21		22		23		24	
9												
10	30		29		28		27		26		25	
11												
12	31		32		33		34		35		36	
13												

I, Stephan J. Szyszkoski, in a field survey on _____, 20____ do hereby state that under requirements of P.A. 74, Michigan P.A. of 1970, the corner points mentioned in lines 1 and 2 above were in conformance with regulations and rules therefore as required in the current manual of survey instructions of the United States Department of the Interior, Bureau of Land Management or by a decree of a Court of Law and /or that the corner points mentioned in lines 3, 4 and 5 above were in conformance with the rules of the Michigan Board of Land Surveyors or by a Decree of a Court of Law; established, re-established, monumented, recovered, found as expressed below:

NOTE: Not more than 2 corners, all in the same town and range, may be recorded on this certificate.

A. Description of original monument and accessories and/or subsequent restoration:

(E8) Quarter corner common to Sections 20 and 21. 1851 - Established by Harvey Mellen, DS: " S6'E between Sections 20 & 21 ... 40.00 Set post 1/4 Sec. corner. Cedar 16 N4E 16 links, Lynn 14 N64W 14 links. ...61.84 Intersected Left bank of Brule River and set post". Notes of Gary L. Pisoni PS, show position for this corner located by proportionate measurement to the original record between Section corner E7 and Meander Corner between Section 20 and 21. Mr. Pisoni gives distances of 2627.34 from E7 to E8 and 4061.86 from E7 to the MC.

(C7) Corner common to Sections 17-18-19-20. 1851 - Established by Harvey Mellen, DS: " S6'E between Sections 17 & 18 ...80.00 Set post at corner of Secs. 17, 18, 19, & 20. Hemlock 12 N62E 21 links, Cedar 14 N72W 9 links". 2003 - Corner remonumented by Gary L Pisoni PS: "Replaced bent pin with a 5/8"x30" rebar 4" below ground surface located west side woods road. 4" Ironwood N70E 46.70', 11" Red Maple S59E 17.35', 13" Basswood S50W 41.70', 10" Red Maple N57W 17.90', Rail N57W 2.9'.

B. Description of corner evidence found and/or method applied in restoring or reestablishing corner:


(E8) The original post and accessories were not recovered. Reestablished the corner in accordance with previous location of Gary L. Pisoni PS, by prorating against his measure between corner E7 and a Witness Corner to the MC between Sections 20 and 21. The MC is described as being 14.22' north of the MC. The position thus established falls on line between said corners, 2627.48' south of E7 and 1434.60' north of the MC (1420.38' north of the MCNC).

(C7) The original post and accessories were not recovered. The 2003 monument was not recovered. Reestablished the corner in accord with the 2003 witnesses of record. Drove a 1" pipe with 4" aluminum cap at the position for the corner, 3" below grade.

C. Description of monument for corner and accessories established to perpetuate locating the position of the corner:

(E8) Set 1"IDx32" I.pipe with 4" alum. MDNR cap. Set measuring nails in:
 6" Sugar N31W 19.1' mrkd "1/4S NBT"
 5" Sugar N05E 20.3' do
 8" Cedar S71E 40.1' do
 9" Sugar S46W 39.8' do
 Set sq'd cedar post adjacent. Bearings are magnetic. Distances are to nail with tag.

(C7) Set 1"IDx32" I.pipe with 4" alum. MDNR cap 3" below grade. Fd. measuring nails in the following 3 NBTs:
 10" Maple N54W 17.9'
 4" Ironwood N70E 46.7'
 11" Maple S57E 17.4'
 4" Sugar S65W 32.6' set nail with tag. Fd. Steel sign post N51W 2.6'
 Bearings are magnetic. Distances are to nail in side of tree.

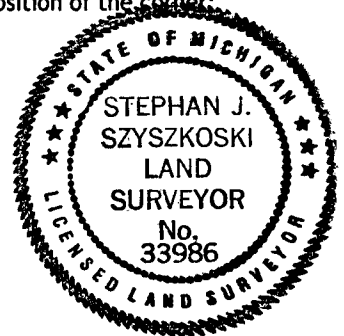

Signed by Stephan J. Szyszkoski
 Surveyor's Michigan License No. 33986

Date 6/13/06

For the Michigan Department of Natural Resources, Office of Land and Facilities