LAND CORNER RECORDATION CERTIFICATE
Filing Requirement of Act 74, Mich. P.A. 1970 as Amended

For corners in

Iron (County)

		Located In:	Corner Code #
1. Public Land Survey		T 42N R 35W	D7
		T___ R___	
		T___ R___	
	S___	T___ R___	
2. Property Controlling	S___	T___ R___	
in Section	S___	T___ R___	
3. Miscellaneous	S___	T___ R___	
Property in Sec.	S___	T___ R___	

Register of Deeds Stamp & File Number

4. Lot No. _____ , Recorded Plat_____
5. Private Claims

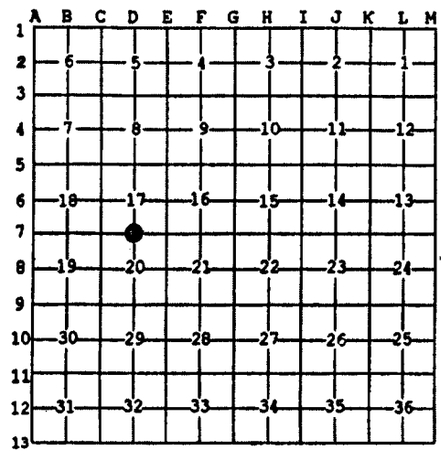

May 25 2006

I, Stephan J. Szyszkoski, in a field survey on _____, 20 ____ do hereby state that under requirements of P.A. 74, Michigan P.A. of 1970, the corner points mentioned in lines 1 and 2 above were in conformance with regulations and rules therefore as required in the current manual of survey instructions of the United States Department of the Interior, Bureau of Land Management or by a decree of a Court of Law and /or that the corner points mentioned in lines 3, 4 and 5 above were in conformance with the rules of the Michigan Board of Land Surveyors or by a Decree of a Court of Law; established, re-established, monumented, recovered, found as expressed below:

NOTE: Not more than 2 corners, all in the same town and range, may be recorded on this certificate.

A. Description of original monument and accessories and/or subsequent restoration:

(D7) Quarter corner common to Sections 17 and 20. 1851 - Established by Harvey Mellen, DS: " N89deg40'W corrected between Sections 17 and 20 ...40.32 Set post 1/4 Sec. corner. Sugar 10 S19E 17 links, Hemlock 30 N65W 12 links. ...80.64 Section corner". Found no subsequent record.

B. Description of corner evidence found and/or method applied in restoring or reestablishing corner:

(D7) The original post and accessories were not recovered. Found no acceptable evidence of the position of the original corner on the ground. Reestablished the corner by single proportionate measurement to the original record between Section corners of record 2654.23' east and west. The position for the corner falls between two ski runs on the ski hill.

C. Description of monument for corner and accessories established to perpetuate locating the position of the corner:

(D7) Set 1"IDx32" I.pipe with 4" alum.
MDNR cap. Set measuring nails in:
8" Sugar S22E 7.6' mrkd "1/4S NBT"
6" Sugar S17W 28.8' do
8" Sugar S73W 23.7' do
13" Sugar N19W 36.9' do
Set sq'd cedar post adjacent. Bearings are magnetic. Distances are to nail with tag.

STATE OF MICHIGAN
STEPHAN J. SZYSZKOSKI
LAND SURVEYOR
No. 33986
LICENSED LAND SURVEYOR

Signed by Stephan J. Szyszkoski Date 6/13/06

Surveyor's Michigan License No. 33986

For the Michigan Department of Natural Resources, Office of Land and Facilities

FORM APPROVED BY MICHIGAN STATE BOARD OF PROFESSIONAL SURVEYORS, JAN. 28, 1971
Revised May 14, 1975
Revised Jan., 1983
Revised Oct., 1995