

LAND CORNER RECORDATION CERTIFICATE
Filing Requirement of Act 74, Mich. P.A. 1970 as Amended

For corners in

Iron	Located In:	Corner Code #
(County)		
1. Public Land Survey	T <u>42N</u> R <u>35W</u>	<u>MC South of E8</u>
	T <u>42N</u> R <u>35W</u>	<u>C8</u>
	T _____ R _____	_____
2. Property Controlling	S _____ T _____ R _____	_____
in Section	S _____ T _____ R _____	_____
3. Miscellaneous	S _____ T _____ R _____	_____
Property in Sec.	S _____ T _____ R _____	_____

Register of Deeds Stamp & File
Number

4. Lot No. _____, Recorded Plat _____
 5. Private Claims

C8 May 16 2006
 MC Apr 26 2006

	A	B	C	D	E	F	G	H	I	J	K	L	M
1													
2		6		5		4		3		2		1	
3													
4		7		8		9		10		11		12	
5													
6		18		17		16		15		14		13	
7													
8		19		20		21		22		23		24	
9													
10		30		29		28		27		26		25	
11													
12		31		32		33		34		35		36	
13													

I, Stephan J. Szyszkoski, in a field survey on _____, 20____ do hereby state that under requirements of P.A. 74, Michigan P.A. of 1970, the corner points mentioned in lines 1 and 2 above were in conformance with regulations and rules therefore as required in the current manual of survey instructions of the United States Department of the Interior, Bureau of Land Management or by a decree of a Court of Law and /or that the corner points mentioned in lines 3, 4 and 5 above were in conformance with the rules of the Michigan Board of Land Surveyors or by a Decree of a Court of Law; established, re-established, monumented, recovered, found as expressed below:

NOTE: Not more than 2 corners, all in the same town and range, may be recorded on this certificate.

A. Description of original monument and accessories and/or subsequent restoration:

(MC South of E8) Meander corner between Sections 20 and 21 on North bank of Brule River. 1851 - Established by Harvey Mellen DS: " S6'E between Sections 20 & 21 ...61.84 Intersected Left bank of Brule River, set post. Elm 7 N3W 29 links. No other trees near". Records of Gary L. Pisoni PS, Iron River, show found Witness Corner to the original MC 14.22' north of the position for the MC, which now falls in the Brule River. Mr. Pisoni gives a distance to this MC from corner E7 of 4061.86 feet (61.543 chains). The Witness Corner is described as a rebar.

(C8) Quarter corner common to Sections 19 and 20. 1851 - Established by Harvey Mellen, DS: " S6'E between Sections 19 & 20 ...40.00 Set post 1/4 Sec. corner. Hemlock 8 N46E 28 links, Hemlock 14 S38W 31 links. ...72.90 Left bank of Brule River and set post". Found no subsequent record.


B. Description of corner evidence found and/or method applied in restoring or reestablishing corner:

(MC South of E8) The original post and accessories were not recovered. The position for the corner now falls in the Brule River. Found a 5/8" diameter rebar of unknown length, projecting 6" above ground, no nearby witnesses found, 4.5' north of the water's edge of the Brule River (water is high this date) and 4047.86' south of corner E7. This distance is 0.22' longer than that measured by Mr. Pisoni, who relied on this monument to conduct a survey in Section 21. I accepted the monument as a WITNESS CORNER to the original Meander Corner which is 14.22' south. Left the monument in place and drove a plastic cap stamped "MICH DNR PS 33986" onto it.

(C8) The original post and accessories were not recovered. Found no evidence of the position of the original corner on the ground. Reestablished the corner at indexed record bearing and distance south of the Section corner C7. Indexed bearing and distance from C7 to C8 is 500 deg. 17'26"E (true) 2630.51'.

C. Description of monument for corner and accessories established to perpetuate locating the position of the corner:

(MC) Found 5/8" rebar for a WITNESS CORNER 14.22' north of the MC. Placed plastic cap on the MC. Set measuring nails in:	(C8) Set 1" ID I.pipe with 4" alum. MDNR cap. Set measuring nails in:
5" B.Ash N12E 8.9' mrkd "MC MC"	4" Maple N65E 21.8' mrkd "1/4S NBT"
5" Elm N74E 37.6' do	5" Maple S83E 29.3' do
9" B.Ash N50W 22.3' do	4" Spruce S26W 21.3' do
9" B.Ash S85W 30.3' do	4" Spruce N52W 15.2' do
Set sq'd spruce post adjacent. Bearings are magnetic. Distances are to nail with tag.	Set sq'd sugar post adjacent. Bearings are magnetic. Distances are to nail with tag.

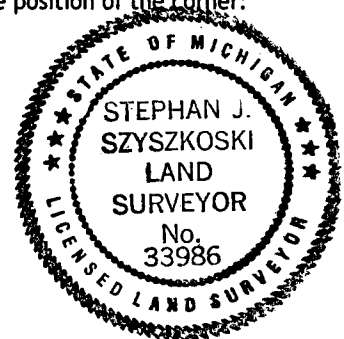

Signed by Stephan J. Szyszkoski
 Surveyor's Michigan License No. 33986

Date 6/13/06

For the Michigan Department of Natural Resources, Office of Land and Facilities