LAND CORNER RECORDATION CERTIFICATE
Filing Requirement of Act 74, Mich. P.A. 1970 as Amended

For corners in

Iron (County)

		Located In:	Corner Code #
1. Public Land Survey		T 42N R 35W	MC south of I12
		T___ R___	
		T___ R___	
	S___	T___ R___	
2. Property Controlling	S___	T 42N R 35W	SMC west of I12
in Section	S___	T___ R___	
3. Miscellaneous	S___	T___ R___	
Property in Sec.	S___	T___ R___	

Register of Deeds Stamp & File Number

4. Lot No. _____ , Recorded Plat_____

5. Private Claims

MC Sep 21 2006
SMC Sep 20 2006

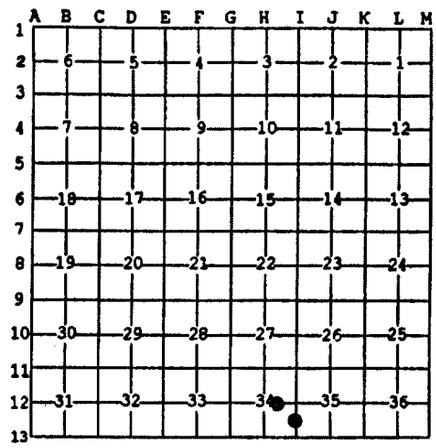

I, Stephan J. Szyszkoski, in a field survey on _____, 20 ____ do hereby state that under requirements of P.A. 74, Michigan P.A. of 1970, the corner points mentioned in lines 1 and 2 above were in conformance with regulations and rules therefore as required in the current manual of survey instructions of the United States Department of the Interior, Bureau of Land Management or by a decree of a Court of Law and /or that the corner points mentioned in lines 3, 4 and 5 above were in conformance with the rules of the Michigan Board of Land Surveyors or by a Decree of a Court of Law; established, re-established, monumented, recovered, found as expressed below:

NOTE: Not more than 2 corners, all in the same town and range, may be recorded on this certificate.

A. Description of original monument and accessories and/or subsequent restoration:

(MC south of I12) Meander corner between Sections 34 and 35 on the left bank of the Brule River. 1851 - Established by Harvey Mellen, Deputy Surveyor: S15'E between Sections 34 & 35 ...40.00 Set post 1/4 Sec. corner ...60.60 Intersected left bank of Brule River. Cedar 12 for Meander corner. Cedar 18 N25E 13 links.
(SMC west of I12) Special Meander corner on the left bank of the Brule River on the E-W 1/4 line of Section 34. Not established in the original survey.

B. Description of corner evidence found and/or method applied in restoring or reestablishing corner:

(MC south of I12) The original corner tree and bearing tree were not recovered. Reestablished the corner at record distance of 20.60 chains south of Quarter corner I12 and on the Section line between Sections 34 and 35, being a line between I11 and I12 produced south. The position for the corner falls in the Brule River and was not monumented. Placed a witness corner on the Section line 24.85' north of the corner position. The top of the left bank of the river is about 7' south of the monument.
(SMC west of I12) Established the corner on the West bank of the Brule River on the E-W 1/4 line of Section 34, being a straight line parallel to the north line of Section 34 passing through quarter corner I12. The SMC is located 1463.03' west of I12.

C. Description of monument for corner and accessories established to perpetuate locating the position of the corner:

(MC) Set 1"IDx32" I.pipe with 4" alum. MDNR cap 24.85' north of the MC position and on the Section line. Set measuring nails in:
5" Balsam N32W 17.7' mrkd "WCMC BT"
4" Balsam N14W 41.0' do
4" Balsam N15E 39.8' do
4" Balsam N54E 46.0' do
Set sq'd balsam post adjacent. Bearings are magnetic. Distances are to nail with tag.

(SMC) Set 1"IDx32" I.pipe with 4" alum. MDNR cap. Set measuring nails in:
5" Balsam N35E 13.3' mrkd "SMC BT"
6" W.Birch S49E 5.1' do
7" Balsam S34E 14.25' do
5" Balsam S07E 16.1' do
Set sq'd cedar post adjacent. Bearings are magnetic. Distances are to nail with tag.

STATE OF MICHIGAN
STEPHAN J. SZYSZKOSKI
LAND SURVEYOR
No. 33986
LICENSED LAND SURVEYOR

Signed by Stephan J. Szyszkoski Date 10/10/06

Surveyor's Michigan License No. 33986

For the Michigan Department of Natural Resources, Office of Land and Facilities

FORM APPROVED BY MICHIGAN STATE BOARD OF PROFESSIONAL SURVEYORS, JAN. 28, 1971
Revised May 14, 1975
Revised Jan., 1983
Revised Oct., 1995