

**LAND CORNER RECORDATION CERTIFICATE**  
**Filing Requirement of Act 74, Mich. P.A. 1970 as Amended**

For corners in

<u>Iron</u> <small>(County)</small>	Located In:	Corner Code #	
1. Public Land Survey	T ___ R ___	_____	
	T ___ R ___	_____	
	T ___ R ___	_____	
	S ___ T ___ R ___	_____	
2. Property Controlling in Section	S <u>9</u> T <u>42N</u> R <u>35W</u>	<u>SMC N. of 11</u>	
	S <u>9</u> T <u>42N</u> R <u>35W</u>	<u>4</u>	
3. Miscellaneous Property in Sec.	S ___ T ___ R ___	_____	
	S ___ T ___ R ___	_____	
4. Lot No. _____, Recorded Plat _____			
5. Private Claims			

Register of Deeds Stamp & File Number

A	B	C	D	E	F	G	H	I	J	K	L	M
1												
2	6		5		4		3		2		1	
3												
4	7		8		9		10		11		12	
5												
6	18		17		16		15		14		13	
7												
8	19		20		21		22		23		24	
9												
10	30		29		28		27		26		25	
11												
12	31		32		33		34		35		36	
13												

Nov 22 2005

I, Stephan J. Szyszkoski, in a field survey on \_\_\_\_\_, 20\_\_ do hereby state that under requirements of P.A. 74, Michigan P.A. of 1970, the corner points mentioned in lines 1 and 2 above were in conformance with regulations and rules therefore as required in the current manual of survey instructions of the United States Department of the Interior, Bureau of Land Management or by a decree of a Court of Law and /or that the corner points mentioned in lines 3, 4 and 5 above were in conformance with the rules of the Michigan Board of Land Surveyors or by a Decree of a Court of Law; established, re-established, monumented, recovered, found as expressed below:

**NOTE: Not more than 2 corners, all in the same town and range, may be recorded on this certificate.**

**A. Description of original monument and accessories and/or subsequent restoration:**


(SMC North of 11) Special Meander corner common to Government Lots 2 and 3 on the southeasterly shore of Snipe Lake. Not established in the original survey. This SMC is north of 1/16 corner #11 in Section 9.  
 (4-Sec. 9) Northwest 1/16 corner, Section 9. Not established in the original survey. The original plat of T42N-R35W shows this corner at the NW'ly shore of Snipe Lake.

**B. Description of corner evidence found and/or method applied in restoring or reestablishing corner:**

(SNC) Established the corner on the West N-S 1/16 line of Section 9 in mineral soil along the southeasterly shore of Snipe Lake. The position monumented is 30' east of the water's edge and is estimated to be approx. 50' south of the water's edge.  
 (4-Sec. 9) Established the corner at the intersection of straight lines connecting opposite 1/16 corners (the Center-West 1/16 corner of Sec. 9 was computed as being midway and on a straight line between corners E4 and F4, both monumented). The position for this corner now falls in Snipe Lake. I established a WITNESS CORNER to the 1/16 corner at the NW shoreline of Snipe Lake on the North E-W 1/16 line and 400.00' west of the corner position.

**C. Description of monument for corner and accessories established to perpetuate locating the position of the corner:**

(SNC) Set 1"IDx32" I.pipe with 4" alum. MDNR cap. Set measuring nails in: 6" Hemlock S56E 17.5' mrkd "SNC BT" 9" Hemlock S15E 17.9' do 5" Y.Birch S20W 29.0' do 5" Hemlock S76W 20.5' do Set sq'd cedar post adjacent. Bearings are magnetic. Distances are to nail with tag.	(4) Set 1"IDx32" I.pipe with 4" alum. MDNR cap for WITNESS CORNER to the 1/16 corner. The 1/16 corner is 400.00' East. Set measuring nails in: 9" Maple N49E 17.3' mrkd "WC BT" 7" Maple in clump S50W 39.5' do 11" Sugar N89W 19.1' do 11" Sugar N02W 24.6' do Set sq'd cedar post adjacent. Bearings are magnetic. Distances are to nail with tag.
--	---

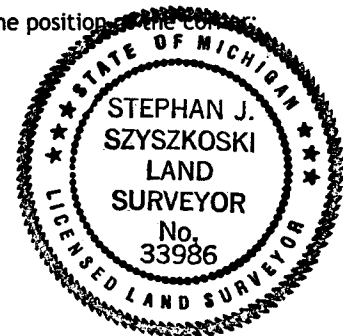

Signed by Stephan J. Szyszkoski  
 Surveyor's Michigan License No. 33986

Date 12/19/05