

LAND CORNER RECORDATION CERTIFICATE
Filing Requirement of Act 74, Mich. P.A. 1970 as Amended

For corners in

Iron	Located In:	Corner Code #
<small>(County)</small>		
1. Public Land Survey	T _____ R _____	_____
	T _____ R _____	_____
	T _____ R _____	_____
	S _____ T _____ R _____	_____
2. Property Controlling in Section	S 20 T 42N R 35W	13
	S 20 T 42N R 35W	SMC South of 13
3. Miscellaneous Property in Sec.	S _____ T _____ R _____	_____
	S _____ T _____ R _____	_____
4. Lot No. _____, Recorded Plat _____		
5. Private Claims		

Register of Deeds Stamp & File Number

May 23 2006

I, Stephan J. Szyszkoski, in a field survey on _____, 20____ do hereby state that under requirements of P.A. 74, Michigan P.A. of 1970, the corner points mentioned in lines 1 and 2 above were in conformance with regulations and rules therefore as required in the current manual of survey instructions of the United States Department of the Interior, Bureau of Land Management or by a decree of a Court of Law and /or that the corner points mentioned in lines 3, 4 and 5 above were in conformance with the rules of the Michigan Board of Land Surveyors or by a Decree of a Court of Law; established, re-established, monumented, recovered, found as expressed below:

NOTE: Not more than 2 corners, all in the same town and range, may be recorded on this certificate.

A. Description of original monument and accessories and/or subsequent restoration:


(13-Sec. 20) Southeast 1/16 corner Section 20. Not established in the original survey. Found no subsequent record.
 (SMC south of 13, Section 20) Special Meander corner on the easterly N-S 1/16 line of Section 20, at its intersection with the north bank of the Brule River. Not established in the original survey.

B. Description of corner evidence found and/or method applied in restoring or reestablishing corner:

(13-Sec. 20) Established the corner at the intersection of straight lines connecting opposite 1/16 corners. The Easterly N-S 1/16 line was run in at the mean bearing of the East line of Section 20 and the N-S 1/4 line of Section 20. The Southerly E-W 1/16 line is a straight line between 1/16 corners #12 and #14, the position of which were located by indexing and prorating, respectively, to the original record.
 (SMC) Established the corner on the easterly N-S 1/16 line of Section 20, run in at the mean bearing of the East line of Section 20 and the N-S 1/4 line of Section 20, and 70.00 feet south of the Southeast 1/16 corner of Section 20 (1/16th corner #13). From the corner monumented, the water's edge of the Brule River is 10.5' south (high water this date).

C. Description of monument for corner and accessories established to perpetuate locating the position of the corner:

(13) Set 1"IDx32" I.pipe with 4" alum. MDNR cap. Set measuring nails in: 7" Sugar S88E 7.3' mrdk "1/16S 8T" 10" Cedar S19W 24.1' do 15" Cedar N53W 58.0' do 13" Cedar N03W 21.6' do	(SMC) Set 1"IDx32" I.pipe with 4" alum. MDNR cap. Set measuring nails in: 16" Cedar N67E 32.0' mrdk "SMC 8T" 5" twin B.Ash S77E 9.0' do 6" B.Ash S52W 16.3' do 6" Sugar N09W 16.0' do
Set sq'd cedar post adjacent. Bearings are magnetic. Distances are to nail with tag.	Set sq'd cedar post adjacent. Bearings are magnetic. Distances are to nail with tag.

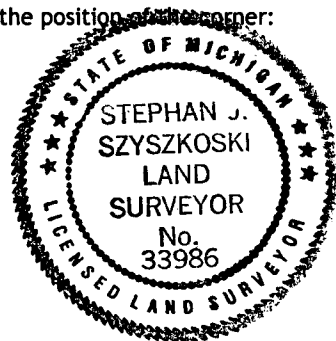

Signed by Stephan J. Szyszkoski
 Surveyor's Michigan License No. 33986

Date 6/13/06