

MAR 9 2000

SECTION

LAND CORNER RECORDATION CERTIFICATE
Filing Requirement of Act 74, Mich. P.A. 1970

For corners in

Form with fields for Iron (County), Located In, Corner Code #, and numbered sections 1-5 for Public Land Survey, Property Controlling, etc.

IRON COUNTY MICHIGAN RECEIVED FOR RECORD

99 DEC 30 AM 10:20
L.C. Records: L. 8, P. 65
[Signature]

Register of Deeds Stamp & File Number

4. Lot No. , Recorded Plat
5. Private Claims

Quarter Corner to Section 13, T43N, R32W
Quarter Corner to Section 18, T43N, R31W

I, Gary L. Pisoni, in a field survey on October 14, 1999 do hereby state that under requirements of P.A. 74, Michigan P.A. of 1970, the corner points mentioned in lines 1 and 2 above were in conformance with regulations and rules therefore as required in the current manual of survey instructions of the United States Department of the Interior, Bureau of Land Management or by a decree of a Court of Law and/or that the corner points mentioned in lines 3, 4 and 5 above were in conformance with the rules of the Michigan Board of Land Surveyors or by a Decree of a Court of Law; established, re-established, monumented, recovered, found as expressed below:

NOTE: Not more than 2 corners, all in the same town and range, may be recorded on this certificate.

Grid table with columns A-M and rows 1-13, containing numbers 1-36.

A. Description of original monument and accessories and/or subsequent restoration:

Original corner established in 1846 by William A. Burt, U.S. Deputy Surveyor.
Original Corner; Cedar Wood Post
Original Bearing Trees:
Fir 6" N 50° E 10 lks (6.60 feet)
Hemlock 13" S 29° W 24 lks (15.84 feet)

PEER GROUP APPROVED
Iron Bay of Pisoni 12-21-99
COUNTY REPRESENTATIVE


B. Description of corner evidence found and/or method applied in restoring or reestablishing corner:

No evidence of original B.T.s found.
Corner restored midway and on line between the Northeast and Southeast Section corners of Section 13.
Corner record research on file with County Representative.

C. Description of monument for corner and accessories established to perpetuate locating the position of the corner:

At the corner position, set a 5/8" diameter by 30" long rebar with a 3" diameter aluminum cap stamped as follows: Iron County Remonumentation, T43N, R32W, R31W, 1/4, S-13, S-18, 1999, RLS 27457 from which I established the following new blazed and scribed bearing trees: (All measurements taken to a nail in side of tree)

Table with 4 columns: Tree Type, Diameter, Bearing, Distance. Includes Balsam, Red Maple, Spruce, Cedar, and Steel sign post.

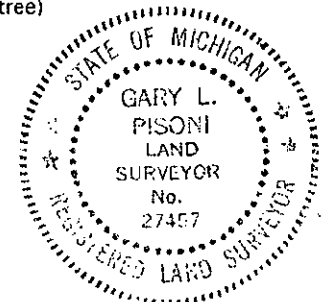

99-65
Signed by Gary L. Pisoni Date 12-28-99
Surveyor's Michigan License No. 27457

FORM APPROVED BY MICHIGAN STATE BOARD OF PROFESSIONAL SURVEYORS, JAN. 28, 1971
REVISED MAY 14, 1975
REVISED JAN., 1993
REVISED OCT., 1995