

LAND CORNER RECORDATION CERTIFICATE  
Filing Requirement of Act 74, Mich. P.A. 1970

IRON COUNTY  
MICHIGAN  
RECEIVED FOR RECORD

SECTION

For corners in

Iron  
(County)

Located In:

Corner Code #

1. Public Land Survey

T 43N R 32W

M-8

T 43N R 31W

A-8 ✓

T \_\_\_\_\_ R \_\_\_\_\_

T \_\_\_\_\_ R \_\_\_\_\_

2. Property Controlling  
in Section

S \_\_\_\_\_ T \_\_\_\_\_ R \_\_\_\_\_

S \_\_\_\_\_ T \_\_\_\_\_ R \_\_\_\_\_

3. Miscellaneous  
Property in Sec.

S \_\_\_\_\_ T \_\_\_\_\_ R \_\_\_\_\_

S \_\_\_\_\_ T \_\_\_\_\_ R \_\_\_\_\_

99 DEC 30 AM 10: 23  
L.C. Records: L. S. P. 78  
*Gibson & Stebbins*  
REGISTERED DEEDS

Register of Deeds Stamp & File Number

4. Lot No. \_\_\_\_\_, Recorded Plat \_\_\_\_\_

5. Private Claims \_\_\_\_\_

Quarter Corner to Section 24, T43N, R32W  
Quarter Corner to Section 19, T43N, R31W

I, Gary L. Pisoni, in a field survey on Oct. 25, 1999, do hereby state that under requirements of P.A. 74, Michigan P.A. of 1970, the corner points mentioned in lines 1 and 2 above were in conformance with regulations and rules therefore as required in the current manual of survey instructions of the United States Department of the Interior, Bureau of Land Management or by a decree of a Court of Law and /or that the corner points mentioned in lines 3, 4 and 5 above were in conformance with the rules of the Michigan Board of Land Surveyors or by a Decree of a Court of Law; established, re-established, monumented, recovered, found as expressed below:

	A	B	C	D	E	F	G	H	I	J	K	L	M
1													
2	6		5		4			3		2			1
3													
4	7		8		9			10		11			12
5													
6	18		17		16			15		14			13
7													
8	19		20		21			22		23			24
9													
10	30		29		28			27		26			25
11													
12	31		32		33			34		35			36
13													

NOTE: Not more than 2 corners, all in the same town and range, may be recorded on this certificate.

A. Description of original monument and accessories and/or subsequent restoration:

Original corner established in August, 1846 by William A. Burt, U.S. Deputy Surveyor.  
Original Corner; Fir Wood Post  
Original Bearing Trees:

Cedar	6"	S 48° E	3 lks (1.98 feet)
Cedar	8"	N 36° W	6 lks (3.96 feet)

PEER GROUP APPROVED  
*Iron County Rep* 12-31-99  
COUNTY REPRESENTATIVE

B. Description of corner evidence found and/or method applied in restoring or reestablishing corner:

No evidence of original B.T.s found.


Restored corner position from a found wood post. Distances along the Range Line are consistent with GLO distances. I accept the wood post as the best available evidence for restoring the corner position.

Corner record research on file with County Representative.

C. Description of monument for corner and accessories established to perpetuate locating the position of the corner:

At the corner position, set a 3/4" diameter aluminum rod monument, 3 feet long and 2" above ground surface with a 3" diameter aluminum cap stamped as follows: Iron County Remonumentation, T43N, R32W, R31W, 1/4, S-24, S-19, 1999, RLS 27457 from which I established the following new blazed and scribed bearing trees: (All measurements taken to a nail in side of tree)

Cedar	9"	N 42° E	5.99 feet
Cedar	7"	S 60° E	4.97 feet
Cedar	8"	S 51° W	27.17 feet
Cedar	12"	N 72° W	24.96 feet
Steel sign post		North	0.71 feet

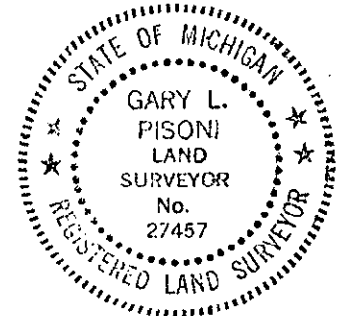

99-78

Signed by Gary L. Pisoni Date 12-28-99

Surveyor's Michigan License No. 27457

FORM APPROVED BY MICHIGAN STATE BOARD OF PROFESSIONAL SURVEYORS, JAN. 28, 1971  
REVISED MAY 14, 1975  
REVISED JAN., 1983  
REVISED OCT., 1995