

MAR 09 2000

SECTION

LAND CORNER RECORDATION CERTIFICATE
Filing Requirement of Act 74, Mich. P.A. 1970

For corners in

<u>Iron</u> (County)	Located In:	Corner Code #
1. Public Land Survey	T <u>43N</u> R <u>31W</u>	<u>G-3</u>
	T _____ R _____	_____
	T _____ R _____	_____
	T _____ R _____	_____
2. Property Controlling in Section	S _____ T _____ R _____	_____
	S _____ T _____ R _____	_____
3. Miscellaneous Property in Sec.	S _____ T _____ R _____	_____
	S _____ T _____ R _____	_____

IRON COUNTY
MICHIGAN
RECEIVED FOR RECORD

99 DEC 30 AM 10:16

L.C. Records: L. S. P. 43

G. L. Pisoni
REGISTERED LAND SURVEYOR

Register of Deeds Stamp & File Number

4. Lot No. _____, Recorded Plat _____
5. Private Claims _____

Section Corner to Sections 3, 4, 9, 10, T43N, R31W

I, Gary L. Pisoni, in a field survey on April 12, 1999 do hereby state that under requirements of P.A. 74, Michigan P.A. of 1970, the corner points mentioned in lines 1 and 2 above were in conformance with regulations and rules therefore as required in the current manual of survey instructions of the United States Department of the Interior, Bureau of Land Management or by a decree of a Court of Law and /or that the corner points mentioned in lines 3, 4 and 5 above were in conformance with the rules of the Michigan Board of Land Surveyors or by a Decree of a Court of Law; established, re-established, monumented, recovered, found as expressed below:

	A	B	C	D	E	F	G	H	I	J	K	L	M
1													
2	6			5			4			3			1
3													
4	7			8			9			10		11	12
5													
6	18			17			16			15		14	13
7													
8	19			20			21			22		23	24
9													
10	30			29			28			27		26	25
11													
12	31			32			33			34		35	36
13													

NOTE: Not more than 2 corners, all in the same town and range, may be recorded on this certificate.

A. Description of original monument and accessories and/or subsequent restoration:

Original corner established on June 19, 1849 by John Burt, U.S. Deputy Surveyor.
Original Corner; Cedar Post
Original Bearing Trees:
Cedar 10" N 12° W 20 lks (13.20 feet)
Hemlock 16" S 52° E 18 lks (11.88 feet)

PEER GROUP APPROVED
Gary L. Pisoni
COUNTY REPRESENTATIVE

B. Description of corner evidence found and/or method applied in restoring or reestablishing corner:

No evidence of original B.T.s found.


Found a 1" diameter iron pin in centerline of a North/South county road and 10" below roadbed surface. Section corner is 31 feet North of a County road running West. I accept the iron pin as the best available evidence for restoring the corner position. Iron pin has been in existence for over 30 years, many surveys are tied to this corner.

Corner record research on file with County Representative.

C. Description of monument for corner and accessories established to perpetuate locating the position of the corner:

Set two (2) reference monuments being a 5/8" diameter by 30" long rebar pin with a 3" diameter aluminum cap stamped as follows: Iron County Remonumentation, T43N, R31W, R.M., S-4, S-3, S-9, S-10, N 65°W, 26.84 feet, 1999, RLS 27457; T43N, R31W, R.M., S-4, S-3, S-9, S-10, S 83° E, 40.81 feet, 1999, RLS 27457 from which I established the following new reference objects:

NW cor. of garage(wood)	N 57° E	38.25 feet
SW cor. of garage(concrete)	S 70° E	34.26 feet
R.M. 5/8" x 30" rebar	S 65° E	26.84 feet
Utility Pole N71-2878	S 23° W	78.86 feet
R.M. 5/8" x 30" rebar	N 83° W	40.81 feet
Utility Pole N71-3005	N 14° W	95.66 feet
Steel sign post	N 83° W	41.6 feet

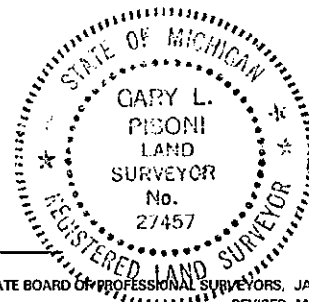

99-43
Signed by Gary L. Pisoni Date 12-28-99
Surveyor's Michigan License No. 27457

FORM APPROVED BY MICHIGAN STATE BOARD OF PROFESSIONAL SURVEYORS, JAN. 28, 1971
REVISED MAY 14, 1975
REVISED JAN., 1983
REVISED OCT., 1995