

**LAND CORNER RECORDATION CERTIFICATE**  
**Filing Requirement of Act 74, Mich. P.A. 1970**

For corners in

Iron	Located In:	Corner Code #
<small>(County)</small>		
1. Public Land Survey	T ___ R ___	_____
	T ___ R ___	_____
	T ___ R ___	_____
	T ___ R ___	_____
2. Property Controlling in Section	S <u>2</u> T 43N R 31W	6
	S <u>2</u> T 43N R 31W	5
3. Miscellaneous Property in Sec.	S ___ T ___ R ___	_____
	S ___ T ___ R ___	_____

Register of Deeds Stamp & File Number

4. Lot No. \_\_\_\_\_, Recorded Plat \_\_\_\_\_  
 5. Private Claims \_\_\_\_\_

Jul 03 2002

I, Stephan J. Szyszkoski, in a field survey on \_\_\_\_\_, 20\_\_ do hereby state that under requirements of P.A. 74, Michigan P.A. of 1970, the corner points mentioned in lines 1 and 2 above were in conformance with regulations and rules therefore as required in the current manual of survey instructions of the United States Department of the Interior, Bureau of Land Management or by a decree of a Court of Law and /or that the corner points mentioned in lines 3, 4 and 5 above were in conformance with the rules of the Michigan Board of Land Surveyors or by a Decree of a Court of Law; established, re-established, monumented, recovered, found as expressed below:

**NOTE:** Not more than 2 corners, all in the same town and range, may be recorded on this certificate.

1	A	B	C	D	E	F	G	H	I	J	K	L	M
2		6		5		4		3		2		1	
3													
4		7		8		9		10		11		12	
5													
6		18		17		16		15		14		13	
7													
8		19		20		21		22		23		24	
9													
10		30		29		28		27		26		25	
11													
12		31		32		33		34		35		36	
13													


A. Description of original monument and accessories and/or subsequent restoration:  
 (6-Sec. 2) Northeast 1/16 corner, Section 2. Not established in the original survey.  
 (5-Sec. 2) North 1/16 corner, Section 2. Not established in the original survey.

B. Description of corner evidence found and/or method applied in restoring or reestablishing corner:

(6-Sec. 2) Established the corner at the intersection of straight lines connecting opposite 1/16 corners.  
 (5-Sec. 2) Established the corner on a straight line between Center of Section 1329.76' south and Quarter corner 1292.52' north, being proportionate to the original record.

C. Description of monument for corner and accessories established to perpetuate locating the position of the corner:

(6) Set 1"IDx32" I.pipe with 4" alum. MDNR cap. Blazed and scribed: 10" Sugar N19E 19.1' "1/16S BT" 10" Sugar S32E 3.3' do 8" Sugar S49W 9.7' do 4" Sugar N32W 13.3' do Set a sq'd cedar post adjacent. Bearings are magnetic. Distances are to notch in lower blaze.	(5) Set 1"IDx32" I.pipe with 4" alum. MDNR cap. Blazed and scribed: 11" Cedar N35E 16.3' "1/16S BT" 3" B.Ash S59E 15.7' do 6" Cedar S44W 6.6' do 8" Cedar N15W 37.8' do Set sq'd cedar post adjacent. Bearings are magnetic. Distances are to notch in lower blaze.
---	--

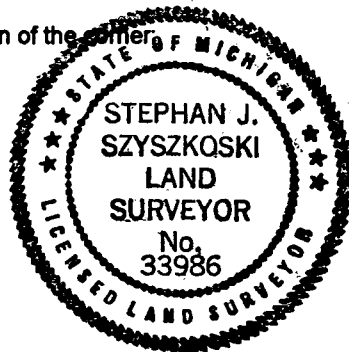

Signed by Stephan J. Szyszkoski  
 Surveyor's Michigan License No. 33986

Date 7/24/02