


LAND CORNER RECORDATION CERTIFICATE
Filing Requirement of Act 74, Mich. P.A. 1970

For corners in

<u>Iron</u> (County)	Located In:	Corner Code #	
1. Public Land Survey	T ___ R ___		
	T ___ R ___		
	T ___ R ___		
	T ___ R ___		
2. Property Controlling in Section	S <u>2</u> T <u>43N</u> R <u>31W</u>		<u>2</u>
	S <u>2</u> T <u>43N</u> R <u>31W</u>		<u>3</u>
3. Miscellaneous Property in Sec.	S ___ T ___ R ___		
	S ___ T ___ R ___		

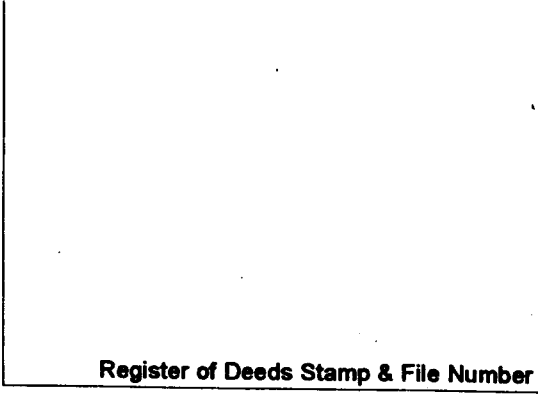

4. Lot No. _____, Recorded Plat _____
5. Private Claims _____

Jul 01 2002

I, Stephan J. Szyszkoski, in a field survey on _____, 20____ do hereby state that under requirements of P.A. 74, Michigan P.A. of 1970, the corner points mentioned in lines 1 and 2 above were in conformance with regulations and rules therefore as required in the current manual of survey instructions of the United States Department of the Interior, Bureau of Land Management or by a decree of a Court of Law and/or that the corner points mentioned in lines 3, 4 and 5 above were in conformance with the rules of the Michigan Board of Land Surveyors or by a Decree of a Court of Law; established, re-established, monumented, recovered, found as expressed below:

NOTE: Not more than 2 corners, all in the same town and range, may be recorded on this certificate.

1	A	B	C	D	E	F	G	H	I	J	K	L	M
2		6		5		4		3		2		1	
3													
4		7		8		9		10		11		12	
5													
6		18		17		16		15		14		13	
7													
8		19		20		21		22		23		24	
9													
10		30		29		28		27		26		25	
11													
12		31		32		33		34		35		36	
13													

A. Description of original monument and accessories and/or subsequent restoration:

(2-Sec. 2) East 1/16 corner between Section 2 T43N-R31W and Section 35 T44N-R31W. 1988: Record of K.L.Sackett, RLS: Established monument on line. Set 1/2" IPx1' in the road. 4" Balsam N39 [sic] 25.4', 3" Balsam N35W 21.7', 12" Spruce S03W 50.9'.
(3-Sec. 2) North 1/16 corner between Sections 2 & 3. Not established in the original survey.


B. Description of corner evidence found and/or method applied in restoring or reestablishing corner:

(2-Sec. 2) The 1988 monument was not recovered. Remonumented the corner midway and on a line of mean true bearing between Section corner 1317.45' East and Quarter corner 1317.45' West. The two remaining 1988 BTs do not fit this position and were recovered as: 6" Balsam N23W 24.1' with overgrown blazes, 8" Balsam N39E 27.3' with overgrown blazes. I believe that the 1988 record is erroneous.
(3-Sec. 2) Established the corner 20 chains, proportionate to the original record north of the Quarter corner and on the Section line. Quarter corner is 1329.80' South and Section corner is 1293.23' North.

C. Description of monument for corner and accessories established to perpetuate locating the position of the corner:

(2) Set 1"IDx32" I.pipe with 4" alum. MDNR cap, buried 5" below the gravel surface of Channing Rd., in its centerline. Blazed and scribed: 7" Spruce N41W 27.5' "1/16S BT" 10" Sugar N02W 31.3' do 6" Spruce N67E 71.3' do 6" Balsam South 20.7' do	(3) Set 1"IDx32" I.pipe with 4" alum. MDNR cap. Blazed and scribed: 8" Sugar N15E 10.5' "1/16S BT" 12" Y.Birch S76E 18.5' do 8" Sugar S15E 18.4' do 9" Sugar S87W 2.1' do Bearings are magnetic. Distances are to notch in lower blaze.
---	--

Bearings are magnetic. Distances are to notch in lower blaze.

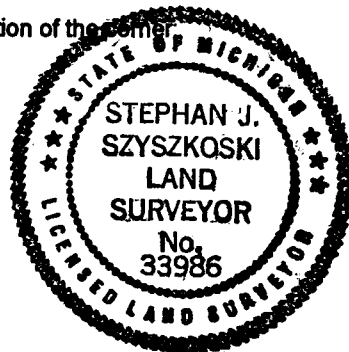

Signed by Stephan J. Szyszkoski
Surveyor's Michigan License No. 33986

Date 7/24/02