

LAND CORNER RECORDATION CERTIFICATE
Filing Requirement of Act 74, Mich. P.A. 1970

For corners in

<u>Iron</u> (County)	Located In:	Corner Code #	
1. Public Land Survey	T 43N R 31W	K2	
	T 43N R 31W	J1	
	T R		
	T R		
2. Property Controlling in Section	S T R		
	S T R		
3. Miscellaneous Property in Sec.	S T R		
	S T R		

Register of Deeds Stamp & File Number

4. Lot No. _____, Recorded Plat _____
 5. Private Claims _____

J1 Jul 01 2002
 K2 Jun 27 2002

I, Stephan J. Szyszkoski, in a field survey on _____, 20____ do hereby state that under requirements of P.A. 74, Michigan P.A. of 1970, the corner points mentioned in lines 1 and 2 above were in conformance with regulations and rules therefore as required in the current manual of survey instructions of the United States Department of the Interior, Bureau of Land Management or by a decree of a Court of Law and /or that the corner points mentioned in lines 3, 4 and 5 above were in conformance with the rules of the Michigan Board of Land Surveyors or by a Decree of a Court of Law; established, re-established, monumented, recovered, found as expressed below:

NOTE: Not more than 2 corners, all in the same town and range, may be recorded on this certificate.

	A	B	C	D	E	F	G	H	I	J	K	L	M
1										●			
2	6		5		4		3			2	●	1	
3													
4	7		8		9		10		11		12		
5													
6	18		17		16		15		14		13		
7													
8	19		20		21		22		23		24		
9													
10	30		29		28		27		26		25		
11													
12	31		32		33		34		35		36		
13													


A. Description of original monument and accessories and/or subsequent restoration:
 (K2) Quarter corner common to Sections 1-2. 1849: Established by John Burt: South true line...39.43 Set cedar qr. sect. post. Cedar 6 N43W 18, Cedar 8 S32E 35...79.43 Section corner". Found no subsequent record.
 (J1) Quarter corner common to Section 2 T43N-R31W and Section 35 T44N-R31W. 1846: Established by John Burt: "West...40.00 Set cedar qr Section post. Cedar 8 N52E 41. Lynn 15 N38W 25...80.00 Set...Corner of Sections 34 & 35". 1976: Reestablished by Mel Davis, RLS midway and on line between Section Corners 2634.84' east and west. Described as "set iron pipe at north edge of road".

B. Description of corner evidence found and/or method applied in restoring or reestablishing corner.

(K2) The original post and accessories were not recovered. Reestablished the corner on a line of mean true bearing between Section corners 2659.76' South and 2621.87' North, being proportionate to the original record.
 (J1) The original post and accessories have been destroyed by road construction and were not recovered. The 1976 monument was not recovered. Reestablished the corner midway and on a line of mean true bearing between Section corners 2634.89 ft. east and west. The corner position falls 7.5' north of the centerline of the gravel surface of Channing Road.

C. Description of monument for corner and accessories established to perpetuate locating the position of the corner.

(K2) Set 1"IDx32" I.pipe with 4" alum. MDNR cap. Blazed and scribed: 5" twin Cedar N78E 8.8' "1/4S NBT" 7" Cedar S11E 15.8' do 5" Cedar S51W 10.7' do 8" Cedar N20W 8.5' do Bearings are magnetic. Distances are to notch in lower blaze.	(J1) Set 1"IDx32" I.pipe with 4" alum. MDNR cap 6" below gravel surface. Blazed and scribed: 6" Basswood N17W 25.5' "1/4S NBT" 6" Basswood in clump S05E 48.0' do 5" Sugar S74W 98.0' do 4" Spruce N75W 60.7' do Bearings are magnetic. Distances are to notch in lower blaze.
--	---

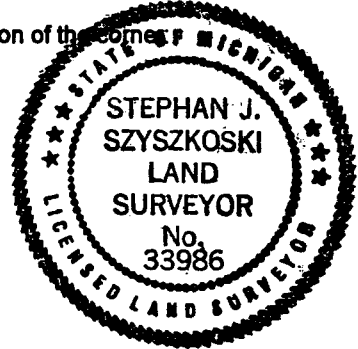

Signed by Stephan J. Szyszkoski
 Surveyor's Michigan License No. 33986

Date 7/24/02