


**LAND CORNER RECORDATION CERTIFICATE**  
**Filing Requirement of Act 74, Mich. P.A. 1970**

For corners in

Iron _____	Located In:	Corner Code #
(County)		
1. Public Land Survey	T 43N R 31W	J10
	T 43N R 31W	J9
	T _____ R _____	_____
	T _____ R _____	_____
2. Property Controlling in Section	S _____ T _____ R _____	_____
	S _____ T _____ R _____	_____
3. Miscellaneous Property in Sec.	S _____ T _____ R _____	_____
	S _____ T _____ R _____	_____

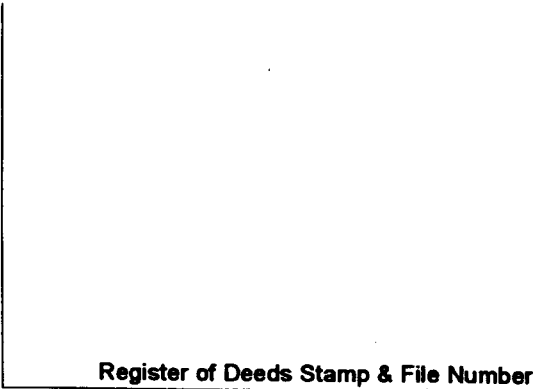

4. Lot No. \_\_\_\_\_, Recorded Plat \_\_\_\_\_  
 5. Private Claims \_\_\_\_\_

J9 Aug 23 2001  
 J10 Oct 31 2001

I, Stephan J. Szyszkoski, in a field survey on \_\_\_\_\_, 20\_\_\_\_ do hereby state that under requirements of P.A. 74, Michigan P.A. of 1970, the corner points mentioned in lines 1 and 2 above were in conformance with regulations and rules therefore as required in the current manual of survey instructions of the United States Department of the Interior, Bureau of Land Management or by a decree of a Court of Law and /or that the corner points mentioned in lines 3, 4 and 5 above were in conformance with the rules of the Michigan Board of Land Surveyors or by a Decree of a Court of Law; established, re-established, monumented, recovered, found as expressed below:

**NOTE: Not more than 2 corners, all in the same town and range, may be recorded on this certificate.**

	A	B	C	D	E	F	G	H	I	J	K	L	M
1													
2	6		5		4		3		2		1		
3													
4	7		8		9		10		11		12		
5													
6	18		17		16		15		14		13		
7													
8	19		20		21		22		23		24		
9										●			
10	30		29		28		27		25	●			
11													
12	31		32		33		34		35		36		
13													

**A. Description of original monument and accessories and/or subsequent restoration:**

(J10) Center of Section 26. Not established in the original survey. Robert F. Perkins, RLS, on a survey dated 12/11/1981 for James Butler, shows the corner being monumented by an iron bar 6.5' east of road C/L. Witnesses: P.Pole N13E 157.4', P.Pole S8E 162.05'. Mr. Perkins shows the bar on a straight line between 1/4 corner 2641.95' north and 1/4 corner (midpoint) 2639.84' south. The 1/4 line to the east was established and monumented in the 1981 survey and that 1/4 line was subsequently used to create additional parcels in Section 26 by Mr. Perkins in a 1990 survey for Francis Drake.

(J9) Quarter corner common to Sections 23-26. Previously described in 1981 by R.F.Perkins, RLS: Found iron in road C/L. Cedar 5" S66W 37.3', Cedar 6" N32W 46.0', 2.5" I.P. road sign S36E 30.5'. Mr. Perkins used this monument to control at least 3 surveys in Section 26 between 1981 and 1990.

**B. Description of corner evidence found and/or method applied in restoring or reestablishing corner:**


(J10) The iron bar was not recovered. The P.Pole witnesses shown on the 1981 survey have been moved. The road at this position has been improved and lifted about 2.5', according to Iron Co. Rd. Commission. Had no reading from metal detector at bottom of 2' deep hole dug in the road. Reestablished the corner in accordance with and proportionate to Mr. Perkins' prior work of 1981 and 1990 on a straight line between the monumented 1/4 corner 2642.01' north and the midpoint between monumented I11 and K11 2639.90' south. The position thus established agrees very well with Mr. Perkins' 1981 and 1990 work to the east.

(J9) Found an iron pin 18" below asphalt surface of Way Dam Rd. at substantial record bearing and distance from the 1981 witness Cedar SW and the road sign SE. Accepted same as marking the corner position and from it commenced a survey for the Michigan Dept. of Natural Resources Mitchell Lake Public Access Site.

**C. Description of monument for corner and accessories established to perpetuate locating the position of the corner:**

(J10) Set a 1"IDx32" I.pipe with plastic cap "Mich DNR LS 33986" in the road, the top of the pipe being 3.5" below asphalt surface. Placed a PK nail directly above the pipe at road surface.  
 P.Pole N12E 162.08' PK nail/washer  
 P.Pole S06E 161.43' do  
 Set 1" capped I.P. ref. cor. N45W 35.0'  
 Set 1" capped I.P. ref. cor. S45W 35.0'  
 The corner lies 8.7' east of the road  
 C/L. Bearings are magnetic.

(J9) Found iron pin 18" below grade. Blazed and scribed the following:  
 7" Cedar S47W 36.5' "1/4S N8T"  
 6" Cedar N67W 33.9' do  
 The above distances are to notch in lower blaze. The 1981 wits:  
 6" Cedar S69W 37.2' to a nail  
 2.5" I.Pipe sign post S32E 30.7' to face  
 All bearings are magnetic.

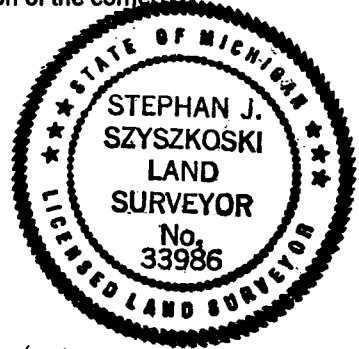

Signed by Stephan J. Szyszkoski  
 Surveyor's Michigan License No. 33986

Date 5/9/02