LAND CORNER RECORDATION CERTIFICATE
Filing Requirement of Act 74, Mich. P.A. 1970 as Amended

For corners in

Iron
(County)

Located In: Corner Code #

1. Public Land Survey T 43N R 31W J6
   T___ R___
   T___ R___
   S___ T___ R___
2. Property Controlling S___ T___ R___
   in Section S___ T___ R___
3. Miscellaneous S___ T___ R___
   Property in Sec. S___ T___ R___

Register of Deeds Stamp & File Number

4. Lot No. _____ , Recorded Plat_____
5. Private Claims

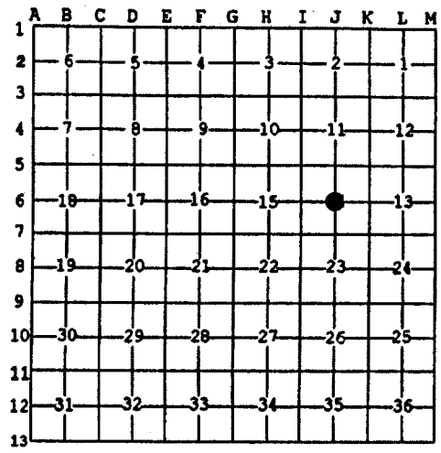

Apr 04 2005

I, Stephan J. Szyszkoski, in a field survey on _____, 20 ____ do hereby state that under requirements of P.A. 74, Michigan P.A. of 1970, the corner points mentioned in lines 1 and 2 above were in conformance with regulations and rules therefore as required in the current manual of survey instructions of the United States Department of the Interior, Bureau of Land Management or by a decree of a Court of Law and /or that the corner points mentioned in lines 3, 4 and 5 above were in conformance with the rules of the Michigan Board of Land Surveyors or by a Decree of a Court of Law; established, re-established, monumented, recovered, found as expressed below:

NOTE: Not more than 2 corners, all in the same town and range, may be recorded on this certificate.

A. Description of original monument and accessories and/or subsequent restoration:

(J6) Center of Section 14. Not established in the original survey.

B. Description of corner evidence found and/or method applied in restoring or reestablishing corner:

(J6) Established the corner at the intersection of straight lines connecting opposite Quarter corners.

C. Description of monument for corner and accessories established to perpetuate locating the position of the corner:

(J6) Set 1"IDx32" I.pipe with 4" alum.
MDNR cap. Set measuring nails in:
7" B.Spruce N71E 4.0' mrkd "C1/4 BT"
5" B.Spruce S32E 31.7' do
4" B.Spruce S75W 46.3' do
7" B.Spruce N51W 9.6' do
Set cedar post adjacent. Bearings are magnetic. Distances are to nail with tag.

STATE OF MICHIGAN
STEPHAN J. SZYSZKOSKI
LAND SURVEYOR
No. 33986
LICENSED LAND SURVEYOR

Signed by Stephan J. Szyszkoski Date 4/5/05

Surveyor's Michigan License No. 33986

For the Michigan Department of Natural Resources, Office of Land and Facilities

FORM APPROVED BY MICHIGAN STATE BOARD OF PROFESSIONAL SURVEYORS, JAN. 28, 1971
Revised May 14, 1975
Revised Jan., 1983
Rervised Oct., 1995