

**LAND CORNER RECORDATION CERTIFICATE**  
 Filing Requirement of Act 74, Mich. P.A. 1970 as Amended

For corners in

Iron (County)	Located In:	Corner Code #
1. Public Land Survey	T 43N R 31W	A10
	T _____ R _____	_____
	T _____ R _____	_____
2. Property Controlling in Section	S _____ T _____ R _____	_____
	S 30 T 43N R 31W	10
	S _____ T _____ R _____	_____
3. Miscellaneous Property in Sec.	S _____ T _____ R _____	_____
	S _____ T _____ R _____	_____
4. Lot No. _____, Recorded Plat _____		
5. Private Claims		

Register of Deeds Stamp & File Number

	A	B	C	D	E	F	G	H	I	J	K	L	M
1													
2	6		5		4		3		2		1		
3													
4	7		8		9		10		11		12		
5													
6	18		17		16		15		14		13		
7													
8	19		20		21		22		23		24		
9													
10	30		29		28		27		26		25		
11													
12	31		32		33		34		35		36		
13													

I, Stephan J. Szyszkoski, in a field survey on \_\_\_\_\_  
 that under requirements of P.A. 74, Michigan P.A. of 1970, the corner points mentioned in lines 1 and 2  
 above were in conformance with regulations and rules therefore as required in the current manual of survey  
 instructions of the United States Department of the Interior, Bureau of Land Management or by a decree of  
 a Court of Law and /or that the corner points mentioned in lines 3, 4 and 5 above were in conformance with  
 the rules of the Michigan Board of Land Surveyors or by a Decree of a Court of Law; established,  
 re-established, monumented, recovered, found as expressed below:

**NOTE:** Not more than 2 corners, all in the same town and range, may be recorded  
 on this certificate.

**A. Description of original monument and accessories and/or subsequent restoration:**

(A10) Quarter corner common to Section 30 T43N-R31W and Section 25 T43N-R32W. 1972 - A.O. Enger RLS  
 reestablished the corner by proportionate measurement to the original record between Section corners  
 40.102 chains north and south. Set 1"IDx36" I.pipe with 4" aluminum cap. Cedar 6" S07E 3.9', Cedar  
 6" N58E 28.3'.

(10-Sec. 30) South 1/16 corner between Section 30 T43N-R31W and Section 25 T43N-R32W. Not  
 established in the original survey.

**B. Description of corner evidence found and/or method applied in restoring or reestablishing corner:**

(A10) Found the 1972 monument in good condition and at record bearing and distance from the 1972  
 witnesses. The Cedar NBT SE is a stump. The Cedar NBT NE is a rotted stump. Found the monument to  
 be correctly situated, as described in the 1972 record, between the Section corners north and south.  
 Accepted same as a careful and faithful reestablishment of the position of the original corner.

(10-Sec. 30) Established the corner on the Range line between Section corner 1322.79' south and  
 Quarter corner 1322.79' north.


**C. Description of monument for corner and accessories established to perpetuate locating the position of the corner:**

(A10) Fd. 1"ID I.pipe with 4" alum. MDNR cap.  
 Set measuring nail with MDNR tag in the side of:  
 8" twin Cedar N35E 42.8' mrkd "1/4S NBT"  
 6" Balsam S50E 16.7' do  
 10" Maple in clump N77W 31.3' do  
 5" Cedar N42W 29.8' do  
 Set sq'd Cedar post adjacent.  
 Bearings are magnetic.

(10) Set 1"IDx32" I.pipe with 4" alum. MDNR cap.  
 Set measuring nail with MDNR tag in the side of:  
 5" Poplar N03E 54.3' mrkd "1/16S BT"  
 3" Poplar S49W 34.0' do  
 4" Poplar N55W 42.9' do  
 4" Poplar N37W 50.8' do  
 Set cedar post adjacent. Bearings magnetic.

Signed by Stephan J. Szyszkoski  
 Surveyor's Michigan License No. 33986

Date 05/03/2010

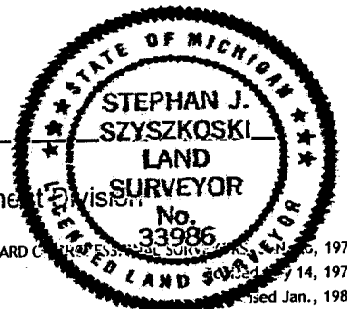

For the Michigan Department of Natural Resources and Environment, Forest Management Division