

**LAND CORNER RECORDATION CERTIFICATE**  
 Filing Requirement of Act 74, Mich. P.A. 1970 as Amended

For corners in

Iron	Located In:	Corner Code #
(County)		
1. Public Land Survey	T _____ R _____	_____
	T _____ R _____	_____
	T _____ R _____	_____
2. Property Controlling in Section	S 11 T 43N R 31W	3
	S 11 T 43N R 31W	8
	S _____ T _____ R _____	_____
3. Miscellaneous Property in Sec.	S _____ T _____ R _____	_____
	S _____ T _____ R _____	_____
4. Lot No. _____, Recorded Plat _____		
5. Private Claims		

Register of Deeds Stamp & File Number

	A	B	C	D	E	F	G	H	I	J	K	L	M
1													
2	6		5		4		3		2				1
3													
4	7		8		9		10		11				12
5													
6	18		17		16		15		14				13
7													
8	19		20		21		22		23				24
9													
10	30		29		28		27		26				25
11													
12	31		32		33		34		35				36
13													

I, Stephan J. Szyszkoski, in a field survey on 8 04/29/2009 do hereby state that under requirements of P.A. 74, Michigan P.A. of 1970, the corner points mentioned in lines 1 and 2 above were in conformance with regulations and rules therefore as required in the current manual of survey instructions of the United States Department of the Interior, Bureau of Land Management or by a decree of a Court of Law and /or that the corner points mentioned in lines 3, 4 and 5 above were in conformance with the rules of the Michigan Board of Land Surveyors or by a Decree of a Court of Law; established, re-established, monumented, recovered, found as expressed below:

**NOTE: Not more than 2 corners, all in the same town and range, may be recorded on this certificate.**

**A. Description of original monument and accessories and/or subsequent restoration:**

(3-Sec. 11) North 1/16 corner between Sections 10 and 11. Not established in the original survey.

(8-Sec. 11) West 1/16 corner, Section 11. Not established in the original survey.

**B. Description of corner evidence found and/or method applied in restoring or reestablishing corner:**

(3-Sec. 11) Established the corner midway and on the Section line between Section corner 1316.40' north and Quarter corner 1316.40' south.

(8-Sec. 11) Established the corner midway and on a straight line between Quarter corner 1332.69' west and the intersection of Quarter lines of Section 11 1332.69' east.


**C. Description of monument for corner and accessories established to perpetuate locating the position of the corner:**

(3) Set 1"IDx32" I.pipe with 4" alum. MDNR cap. Set measuring nail with MDNR tag in the side of:  
 6" Sugar N21W 27.7' mrkd "1/16S BT"  
 10" Y.Birch N79E 10.4' do  
 6" Sugar South 24.0' do  
 6" twin Sugar N45W 18.7' do  
 Set sq'd cedar post adjacent.  
 Bearings are magnetic.

(8) Set 1"IDx32" I.pipe with 4" alum. MDNR cap. Set measuring nail with MDNR tag in the side of:  
 10" Y.Birch N01W 19.6' mrkd "1/16S BT"  
 6" Maple N80E 21.2' do  
 11" W.Birch S11W 4.6' do  
 11" Maple S88W 14.75' do  
 Set sq'd Cedar post adjacent.  
 Bearings are magnetic.

Signed by Stephan J. Szyszkoski  
 Surveyor's Michigan License No. 33986

Date 06/09/2009

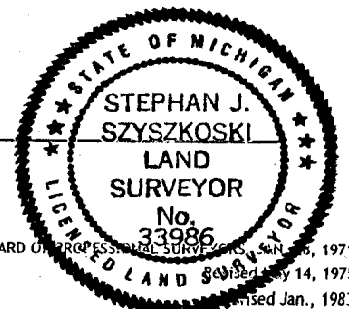

For the Michigan Department of Natural Resources, Office of Land and Facilities