

FEB 23 1996

LAND CORNER RECORDATION CERTIFICATE
Filing Requirement of Act 74, Mich. P.A. 1970

IRON COUNTY
MICHIGAN
RECEIVED FOR RECORD

95 JAN 17 AM 8:42
L.C. RECORDS L.G. P. 324-325

Edwin Stebbins
REGISTER OF DEEDS

For corners in

Iron

(County)

Located In:

Corner Code #

- | | | | |
|------------------------------------|-------|-------|------------|
| 1. Public Land Survey Section 6 | T 43N | R 32W | <u>A-2</u> |
| | T 43N | R 33W | M-2 |
| | T | R | |
| | T | R | |
| 2. Property Controlling In Section | S | T | R |
| | S | T | R |
| 3. Miscellaneous Property in Sec. | S | T | R |
| | S | T | R |

Register of Deeds Stamp & File Number

4. Lot No. _____, Recorded Plat _____
5. Private Claims _____
W 1/4 Section 6

	A	B	C	D	E	F	G	H	I	J	K	L	M
2	6	5	4	3	2	1							
3													
4	7	8	9	10	11	12							
5													
6	16	17	18	19	20	21	22	23	24				
7													
8	19	20	21	22	23	24							
9													
10	30	29	28	27	26	25							
11													
12	31	32	33	34	35	36							
13													

I, John R. Garske, in a field survey on November 1, 1994, do hereby certify that under requirements of P.A. 74, Michigan P.A. of 1970, the corner points mentioned in lines 1 and 2 above were in conformance with regulations and rules therefore as required in the current manual of survey instructions of the United States Department of the Interior, Bureau of Land Management or by a decree of a Court of Law and/or that the corner points mentioned in lines 3, 4 and 5 above were in conformance with the rules of the Michigan Board of Land Surveyors or by a Decree of a Court of Law; established, re-established, monumented, re-monumented, recovered, found as expressed below:

NOTE: Not more than 4 corners, all in the same town and range, may be recorded on this certificate.

A. Description of original monument and accessories and/or subsequent restoration:

1846 - Township Boundary by Austin Burt. Original bearing trees: Sugar 6" - S41°E, 10; Fir 7" - N20°W, 10.

1969 - MDOT construction plans, witnesses to corner position: maple 4" - N85°E, 34.50 feet; W. birch 4" - S35°E, 13.50 feet; W. birch 4" - North - 21.50 feet.

B. Description of corner evidence found and/or method applied in restoring or reestablishing corner:

I found a 1 1/4" pipe in a monument box with a fallen wire fence running east. MDOT distance ties shown on plans to centerline check satisfactorily. MDOT plans note that they found the 1 1/4" iron pipe and set the monument box. I accepted the pipe after checking distances north and south to known corners and comparing to private surveys and the MDOT plans. Surveys on the interior of Section 6 have been completed using this corner since 1972.

County Record Reserch and field search forms on file with the County Representative. See sketch on back.


PEER GROUP APPROVED

Iron
COUNTY REPRESENTATIVE
AP 12-15-94

Description of monument for corner and accessories established to perpetuate locating the position of the corner:

Drove a 30" x 5/8" rebar with a 3 1/4" diameter stamped aluminum cap inside the existing pipe and established the following references: Power Pole #94-08038 - N03°E, 84.90 feet; right-of-way post north, 14.82 feet; 7" white birch - N86°E, 86.05 feet; 5" sugar - S05°W, 9.16 feet; centerline U.S. 141 west, 102.65 feet; 6" sugar - N81°W, 18.03 feet.

ned by *John R. Garske* Date 12/13/94
urveyor's Michigan License No. 28410

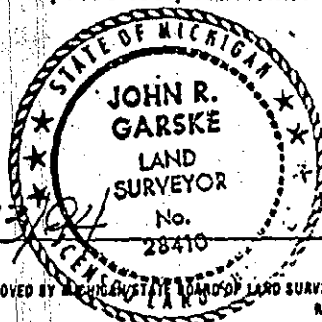

FORM APPROVED BY MICHIGAN STATE BOARD OF LAND SURVEYORS, JAN. 28, 1971
REVISED MAY 14, 1975
REVISED JAN., 1983