SURVEY & MAPPING
FEB 2 ? 1996
COMMISSION

# LAND CORNER RECORDATION CERTIFICATE

**Filing Requirement of Act 74, Mich. P.A. 1970**

IRON COUNTY
MICHIGAN
RECEIVED FOR RECORD
95 JAN 17 AM 8:42
L.C. RECORDS L.6 P.328
Eileen Stalie
REGISTER OF DEEDS

Register of Deeds Stamp & File Number

For corners in Iron (County)

| | Located in: | Corner Code # |
|---|---|---|
| 1. Public Land Survey Section 18 | T 43N R 32W | A-5 |
| | T 43N R 33W | M-5 |
| | T ___ R ___ | |
| | T ___ R ___ | |
| 2. Property Controlling | S ___ T ___ R ___ | |
| in Section | S ___ T ___ R ___ | |
| 3. Miscellaneous | S ___ T ___ R ___ | |
| Property in Sec. | S ___ T ___ R ___ | |

4. Lot No. _____, Recorded Plat _____
5. Private Claims _____
NW Section 18

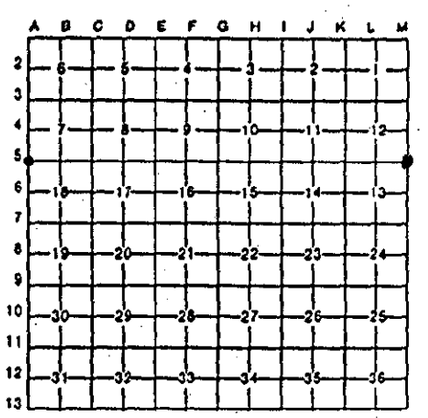


I, John R. Garske, in a field survey on November 1, 1994, do hereby certify that under requirements of P.A. 74, Michigan P.A. of 1970, the corner points mentioned in lines 1 and 2 above were in conformance with regulations and rules therefore as required in the current manual of survey instructions of the United States Department of the Interior, Bureau of Land Management or by a decree of a Court of Law and/or that the corner points mentioned in lines 3, 4 and 5 above were in conformance with the rules of the Michigan Board of Land Surveyors or by a Decree of a Court of Law; established, re-established, monumented, re-monumented, recovered, found as expressed below:

**NOTE: Not more than 4 corners, all in the same town and range, may be recorded on this certificate.**

A. Description of original monument and accessories and/or subsequent restoration:

1846 - Township Boundary by Austin Burt, W. pine 16" - corner of sections. Original bearing trees: W. pine 12" - S88°W, 12; W. pine 20" - N64°E, 28 on correcting line.

1969 - MDOT construction plans show a found 3/4" re-rod, witnesses to corner position: 18" pine - N65°E, 27.69 feet; 18" pine - S40°E, 33.56 feet; T. pole - S75°E, 31.57 feet; 18" pine - N70°W, 28.35 feet.

B. Description of corner evidence found and/or method applied in restoring or reestablishing corner:

I found a 1/2" pin in a monument box approximately 78.3 feet east of (78.55 MDOT) centerline of U.S. 2 and centerline of Soderena Road. The iron pin checks with the 1969 MDOT plans and has been used and accepted in many surveys since 1969. Distances north and south to known corners check with plans. I am accepting this position as the best possible corner location.

County Record Reserch and field search forms on file with the County Representative. See sketch in L.6 P.325 of Land Corner Records.

PEER GROUP APPROVED
TRM Stanley L. Prosen
COUNTY REPRESENTATIVE
A.D. 12-15-94

C. Description of monument for corner and accessories established to perpetuate locating the position of the corner:

Replaced 1/2" pin with a 2" stamped aluminum cap on a 30" x 5/8" rebar inside the monument box and established the following references: 20" red pine - N60°E, 27.81 feet; 5" white pine - S82°E, 36.04 feet; 18" red pine - S40°E, 33.56 feet; SSP - east, 0.86 feet; SSP - west, 3.59 feet.

STATE OF MICHIGAN
JOHN R. GARSKE
LAND SURVEYOR
No. 28410
LICENSED LAND SURVEYOR

Signed by John R Garske Date 12/12/94

Surveyor's Michigan License No. 28410

FORM APPROVED BY MICHIGAN STATE BOARD OF LAND SURVEYORS, JAN. 28, 1971
REVISED MAY 14, 1975
REVISED JAN., 1983