

FEB 22 1996

COMMISSION

LAND CORNER RECORDATION CERTIFICATE

Filing Requirement of Act 74, Mich. P.A. 1970

IRON COUNTY MICHIGAN RECEIVED FOR RECORD

95 JAN 17 AM 8:42 L.C. RECORDS L. 6 P. 331

Register of Deeds Stamp & File Number

For corners in Iron (County) Located In: Corner Code # 1. Public Land Survey Section 19 T 43N R 32W A-B M-8

4. Lot No. , Recorded Plat 5. Private Claims West 1/4 Section 19

I, John R. Garske, in a field survey on November 1, 1994, do hereby certify that under requirements of P.A. 74, Michigan P.A. of 1970, the corner points mentioned in lines 1 and 2 above were in conformance with regulations and rules therefore as required in the current manual of survey instructions of the United States Department of the Interior, Bureau of Land Management or by a decree of a Court of Law and/or that the corner points mentioned in lines 3, 4 and 5 above were in conformance with the rules of the Michigan Board of Land Surveyors or by a Decree of a Court of Law; established, re-established, monumented, re-monumented, recovered, found as expressed below:

NOTE: Not more than 4 corners, all in the same town and range, may be recorded on this certificate.

A. Description of original monument and accessories and/or subsequent restoration:

1846 - Township Boundary by Austin Burt, D.S. - 40 chains set pine post fir 7" - S63°E, 12 links; aspen 8" - N63°W, 12 links.

Description of corner evidence found and/or method applied in restoring or reestablishing corner:


I found a 3/4" pin in 6"± square concrete monument flush with the ground; also found fallen fence running north-west. No history of this corner position was available. It has, however, been used and accepted for a number of years as noted by a local resident. A 1/16th corner found north on the line is close to a split between the section corner found north. The monument found would be approximately 2 feet south of a proportioned position. I am accepting the monument as the one-quarter corner due to past use and acceptance and its current harmonious position.

County Record Reserch and field search forms on file with the County Representative. See sketch in L.6 P.325 of Land Corner Records.

PEER GROUP APPROVED IRON County Representative

Description of monument for corner and accessories established to perpetuate locating the position of the corner:

Set a 3 1/4" diameter stamped aluminum cap on top of the 3/4" steel pin. Established the following references: 5" red pine - S88°E, 29.37 feet; 4" red pine - S15°W, 8.80 feet; 10" red pine - N80°W, 71.84 feet; 6" red pine - N05°W, 25.82 feet; SSP - west, 1.14 feet.

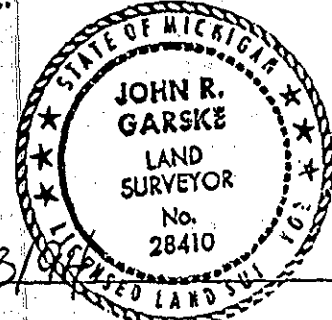

by John R. Garske Date 12/13/94 Surveyor's Michigan License No. 28410