

SURVEY & REMONUMENTATION

JAN 13 1998

SECTION

IRON COUNTY
MICHIGAN
RECEIVED FOR RECORD

97 DEC 23 PM 1:31
L. U. Records L. 7 P. 173

Eileen J. Jelic
REGISTERED DEEDS

LAND CORNER RECORDATION CERTIFICATE
Filing Requirement of Act 74, Mich. P.A. 1970

For corners in

Iron (County)	Located In:	Corner Code #
1. Public Land Survey	T 42N R 33W	M-1
	T 42N R 32W	A-1
	T 43N R 33W	M-13
	T 43N R 32W	<u>A-13</u> ✓
2. Property Controlling in Section	S ___ T ___ R ___	___
	S ___ T ___ R ___	___
3. Miscellaneous Property in Sec.	S ___ T ___ R ___	___
	S ___ T ___ R ___	___

Register of Deeds Stamp & File Number

4. Lot No. _____, Recorded Plat _____
5. Private Claims _____

Section Corner Common to Section 36, T43N, R33W Section 1, T42N, R33W
Section 31, T43N, R32W Section 6, T42N, R32W

I, Gary L. Pisoni, in a field survey on December 1, 1997 do hereby state that under requirements of P.A. 74, Michigan P.A. of 1970, the corner points mentioned in lines 1 and 2 above were in conformance with regulations and rules therefore as required in the current manual of survey instructions of the United States Department of the Interior, Bureau of Land Management or by a decree of a Court of Law and /or that the corner points mentioned in lines 3, 4 and 5 above were in conformance with the rules of the Michigan Board of Land Surveyors or by a Decree of a Court of Law; established, re-established, monumented, recovered, found as expressed below:

	A	B	C	D	E	F	G	H	I	J	K	L	M
1													
2	6	5	4	3	2	1							
3													
4	7	8	9	10	11	12							
5													
6	18	17	16	15	14	13							
7													
8	19	20	21	22	23	24							
9													
10	30	29	28	27	26	25							
11													
12	31	32	33	34	35	36							
13													

NOTE: Not more than 2 corners, all in the same town and range, may be recorded on this certificate.

A. Description of original monument and accessories and/or subsequent restoration:
Original corner established in 1846 by Austin Burt, U.S. Deputy Surveyor.

Original Corner: Cedar Post
Original Bearing Trees:

Hemlock	16"	S 80° E	20 lks (13.2 feet)
Hemlock	22"	N 52° W	8 lks (5.28 feet)

PEER GROUP APPROVED
Gary L. Pisoni 12-19-97
COUNTY REPRESENTATIVE
Iron

B. Description of corner evidence found and/or method applied in restoring or reestablishing corner:

No evidence of original B.T.s found.

Found a fence corner from which a fence line runs North, South and West. Corner located along a steel tower high voltage line.

Distance to:	N 1/4 Corner Section 1	S 89° 57'46"W	2645.35 (meas.)	2640 (GLO)
	E 1/4 Corner Section 1	S 00° 10'14"W	2560.61 (meas.)	2565.42 (GLO)


Accept the fence corner as the best available evidence for restoring the corner position.

Corner record research on file with County Representative.

C. Description of monument for corner and accessories established to perpetuate locating the position of the corner:

At the fence corner position, set a 3/4" outside diameter aluminum rod monument 3 feet long, 2" above ground surface, with a 3" aluminum cap stamped as follows: Iron County Remonumentation, T43N, R33W, R32W, S36, S31, S1, S6, T42N, 1997, RLS 27457 from which the following bear (measurements taken to nail in side of tree)

Utility Tower #66	SW leg bottom West bolt	N 17° E	58.08 feet
Rebar	5/8"x30" C/L of tower line	East	20.51 feet
Elm	7"	S 63° W	81.84 feet
Jack Pine	6"	N 24° W	119.38 feet
Steel sign post		north	0.58 feet

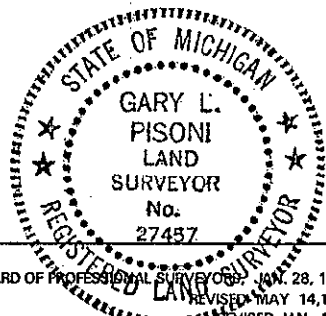

97-3b
Signed by Gary L. Pisoni

Date December 16, 1997

Surveyor's Michigan License No. 27457