

SURVEY & REMONUMENTATION

JAN 19 1999

SECTION

LAND CORNER RECORDATION CERTIFICATE
Filing Requirement of Act 74, Mich. P.A. 1970

For corners in

<u>Iron</u> (County)	Located In:	Corner Code #
1. Public Land Survey	T <u>43N</u> R <u>32W</u>	<u>C-6</u>
	T _____ R _____	_____
	T _____ R _____	_____
	T _____ R _____	_____
2. Property Controlling in Section	S _____ T _____ R _____	_____
	S _____ T _____ R _____	_____
3. Miscellaneous Property in Sec.	S _____ T _____ R _____	_____
	S _____ T _____ R _____	_____

IRON COUNTY
MICHIGAN
RECEIVED FOR RECORD

98 DEC 28 AM 11:23

L.C. Records: L. 7, P. 307
Gary L. Pisoni

Register of Deeds Stamp & File Number

4. Lot No. _____, Recorded Plat _____
5. Private Claims _____

Quarter Corner Sections 18 and 17, T43N, R32W

I, Gary L. Pisoni, in a field survey on Dec. 3, 1998 do hereby state that under requirements of P.A. 74, Michigan P.A. of 1970, the corner points mentioned in lines 1 and 2 above were in conformance with regulations and rules therefore as required in the current manual of survey instructions of the United States Department of the Interior, Bureau of Land Management or by a decree of a Court of Law and /or that the corner points mentioned in lines 3, 4 and 5 above were in conformance with the rules of the Michigan Board of Land Surveyors or by a Decree of a Court of Law; established, re-established, monumented, recovered, found as expressed below:

A	B	C	D	E	F	G	H	I	J	K	L	M
1												
2	6	5	4				3		2		1	
3												
4	7	8	9				10		11		12	
5												
6	18	17	16				15		14		13	
7												
8	19	20	21				22		23		24	
9												
10	30	29	28				27		26		25	
11												
12	31	32	33				34		35		36	
13												

NOTE: Not more than 2 corners, all in the same town and range, may be recorded on this certificate.

A. Description of original monument and accessories and/or subsequent restoration:

Original corner established on August 11, 1849 by Zelotes B. Searls, U.S. Deputy Surveyor
Original Corner: Spruce Wood Post
Original Bearing Trees:

White Birch	8"	S 65° E	20 lks (13.20 feet)
White Birch	6"	N 25° W	22 lks (14.52 feet)

On 6/8/94, Stephan J. Szyszkoski, RLS with the Michigan Dept. of Natural Resources found a 3" diameter cast iron pipe with a spike driven in its center, said pipe being 3" below the road bed surface of Paint River Road, at the Easterly extension of an ancient wire fence line. He accepted the pipe as the best available evidence of the position of the original corner, recorded in L.C. Certificate, Liber 6, Page 317 in 1994.

1994 Bearing Trees:

Chiseled 'x' at NE of Transformer Housing		N 84° E	32.50 feet
5/8" rebar		S 88° E	33.07 feet
Aspen	12"	S 80° E	35.38 feet
Aspen	12"	S 36° E	64.96 feet
Choke Cherry	3"	S 86° W	25.0 feet

B. Description of corner evidence found and/or method applied in restoring or reestablishing corner:

No evidence of original B.T.s found. Found 3" diameter cast iron pipe as described above, 8" below road bed surface and located 4.5 feet West of centerline of Paint River Road and the following bearing trees:

Chiseled 'x' at NE of Transformer Housing		N 84° E	32.46 feet
5/8" rebar		S 89° E	33.04 feet
Aspen	14"	S 80° E	35.39 feet
Aspen	12"	S 36° E	64.93 feet
Choke Cherry	3"	S 84° W	25.18 feet

PEER GROUP APPROVED
Gary L. Pisoni 12-18-98
COUNTY REPRESENTATIVE

Corner record research on file with County Representative.


C. Description of monument for corner and accessories established to perpetuate locating the position of the corner:

From the above described corner position, I set two reference monuments, being a 5/8" diameter by 30" long rebar, with a 3" aluminum cap stamped as follows: Iron County Remonumentation, T43N, R32W, R.M., 1/4, S-18, S-17, N 89° W, 33.04', 1998, RLS 27457; T43N, R32W, R.M., 1/4, S-18, S-17, N 45° E, 37.13', 1998, RLS 27457 from which the following reference object bears:

R.M.	5/8" rebar existing	S 89° E	33.04 feet
R.M.	5/8" x 30" rebar	S 45° W	37.13 feet
	Steel sign post	S 89° E	33.70 feet
	Steel sign post	S 45° W	37.70 feet

98-2
Signed by *Gary L. Pisoni* Date 12-21-98
Surveyor's Michigan License No. 27457

FORM APPROVED BY MICHIGAN STATE BOARD OF PROFESSIONAL SURVEYORS, JAN 28 1971
REVISED MAY 14, 1975
REVISED JAN., 1983
REVISED OCT., 1995

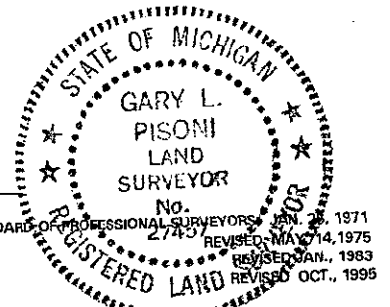

L. 7 P. 307