

SURVEY & REMONUMENTATION

JAN 19 1999

SECTION

LAND CORNER RECORDATION CERTIFICATE
Filing Requirement of Act 74, Mich. P.A. 1970

For corners in

Iron (County)	Located In:	Corner Code #
1. Public Land Survey	T <u>43N</u> R <u>32W</u>	<u>C-8</u>
	T _____ R _____	_____
	T _____ R _____	_____
	T _____ R _____	_____
2. Property Controlling in Section	S _____ T _____ R _____	_____
	S _____ T _____ R _____	_____
3. Miscellaneous Property in Sec.	S _____ T _____ R _____	_____
	S _____ T _____ R _____	_____

IRON COUNTY MICHIGAN
RECEIVED FOR RECORD
98 DEC 28 AM 11:23
L.C. Records: L. 7, P. 303
Gilbert Stebbins
Register of Deeds Stamp & File Number

4. Lot No. _____, Recorded Plat _____
5. Private Claims _____

Quarter Corner Sections 19 and 20, T43N, R32W

I, Gary L. Pisoni, in a field survey on Dec. 12, 1998 do hereby state that under requirements of P.A. 74, Michigan P.A. of 1970, the corner points mentioned in lines 1 and 2 above were in conformance with regulations and rules therefore as required in the current manual of survey instructions of the United States Department of the Interior, Bureau of Land Management or by a decree of a Court of Law and /or that the corner points mentioned in lines 3, 4 and 5 above were in conformance with the rules of the Michigan Board of Land Surveyors or by a Decree of a Court of Law; established, re-established, monumented, recovered, found as expressed below:

A	B	C	D	E	F	G	H	I	J	K	L	M
1												
2	6		5		4		3		2		1	
3												
4	7		8		9		10		11		12	
5												
6	18		17		16		15		14		13	
7												
8	19		20		21		22		23		24	
9												
10	30		29		28		27		26		25	
11												
12	31		32		33		34		35		36	
13												

NOTE: Not more than 2 corners, all in the same town and range, may be recorded on this certificate.

A. Description of original monument and accessories and/or subsequent restoration:

Original corner established on August 9, 1849 by Zelotes B. Searls, U.S. Deputy Surveyor.
Original Corner; Cedar Post
Original Bearing Trees:
Cedar 12" N 35°W 29 lks (19.14 feet)
Cherry 4" N 15° W No distance given

B. Description of corner evidence found and/or method applied in restoring or reestablishing corner:

No evidence of original B.T.s found. Found a drill rod encased in an 8" x 8" concrete slab 4" above ground surface and located along the edge of a railroad grade, corner position was set by the local mining company.

I accept the concrete monument as the best available evidence for restoring the corner position.

Corner record research on file with county representative.

PEER GROUP APPROVED
Iron A. Pisoni 12-18-98
COUNTY REPRESENTATIVE


C. Description of monument for corner and accessories established to perpetuate locating the position of the corner:

From the above described corner position, I set a reference monument, being a 5/8" diameter by 30" long rebar, with a 3" aluminum cap stamped as follows: Iron County Remonumentation, T43N, R32W, R.M., 1/4, S-19, S-20, S 41° E, 1.31', 1998, RLS 27457, from which I blazed and scribed the following new bearing trees: (All measurements taken to a nail in side of tree)

Jack Pine	10"	S 37°E	77.90 feet
Black Cherry	9"	S 06°E	32.28 feet
White Pine	9"	S 87°W	95.49 feet
Popple	12"	N 01°W	49.86 feet
R.M.	5/8" x 30" rebar	N 41°W	1.31 feet
Steel sign post		N 41°W	1.75 feet

98-151
Signed by Gary L. Pisoni Date 12-21-98
Surveyor's Michigan License No. 27457

FORM APPROVED BY MICHIGAN STATE BOARD OF PROFESSIONAL SURVEYORS, JAN. 23, 1971
REVISED MAY 14, 1975
NO. 27457
REVISED JAN, 1983
REVISED OCT., 1995

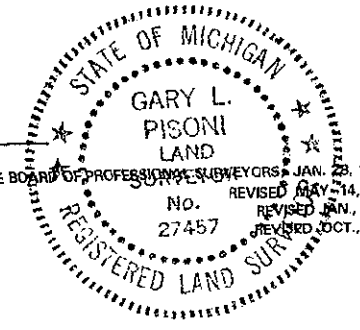

L. 7 P. 303