

RF

MAR 09 2000

SECTION

LAND CORNER RECORDATION CERTIFICATE  
Filing Requirement of Act 74, Mich. P.A. 1970

For corners in

<u>Iron</u> (County)	Located In:	Corner Code #	
1. Public Land Survey	T <u>43N</u> R <u>32W</u>	<u>E-6</u>	
	T _____ R _____	_____	
	T _____ R _____	_____	
	T _____ R _____	_____	
2. Property Controlling in Section	S _____ T _____ R _____	_____	
	S _____ T _____ R _____	_____	
3. Miscellaneous Property in Sec.	S _____ T _____ R _____	_____	
	S _____ T _____ R _____	_____	

IRON COUNTY MICHIGAN  
RECEIVED FOR RECORD

99 DEC 30 AM 10: 18  
L.C. Recylo: L. 8, P. 55  
*Gordon P. Pisoni*  
REGISTERED LAND SURVEYOR

Register of Deeds Stamp & File Number

4. Lot No. \_\_\_\_\_, Recorded Plat \_\_\_\_\_  
5. Private Claims \_\_\_\_\_

Quarter Corner to Sections 16 and 17, T43N, R32W

I, Gary L. Pisoni, in a field survey on October 5, 1999 do hereby state that under requirements of P.A. 74, Michigan P.A. of 1970, the corner points mentioned in lines 1 and 2 above were in conformance with regulations and rules therefore as required in the current manual of survey instructions of the United States Department of the Interior, Bureau of Land Management or by a decree of a Court of Law and /or that the corner points mentioned in lines 3, 4 and 5 above were in conformance with the rules of the Michigan Board of Land Surveyors or by a Decree of a Court of Law; established, re-established, monumented, recovered, found as expressed below:

NOTE: Not more than 2 corners, all in the same town and range, may be recorded on this certificate.

	A	B	C	D	E	F	G	H	I	J	K	L	M
1													
2		6		5		4		3		2		1	
3													
4		7		8		9		10		11		12	
5													
6		18		17		16		15		14		13	
7													
8		19		20		21		22		23		24	
9													
10		30		29		28		27		26		25	
11													
12		31		32		33		34		35		36	
13													

A. Description of original monument and accessories and/or subsequent restoration:

Original corner established on Aug. 16, 1849 by Zelotes B. Searls, Deputy Surveyor.  
Original Corner: Spruce Post  
Original Bearing Trees:  
Yellow Pine 12" S 23° E 7 lks (4.62 feet)  
Yellow Pine 12" N 70° W 17 lks (11.22 feet)

PEER GROUP APPROVED  
*Gary L. Pisoni 12-21-99*  
COUNTY REPRESENTATIVE

On 3/30/94, Stephan J. Szyszkoski RLS re-established the corner position at mid point and on line between the Northeast and Southeast Section corners of Section 17, set a 1" diameter iron pipe with a 4" aluminum cap stamped as follows: T43N, R32W, 1/4, S-17, S-16, 3/30/94, LS 33986, recorded in Liber 6, Page 317 of L.C. records.

1994 Bearing Trees:  
Red Pine 21" N 30° E 54.2 feet  
Red Pine 9" S 46° E 32.3 feet  
Red Pine 11" S 66° W 29.2 feet  
Red Pine 9" N 56° W 34.6 feet

B. Description of corner evidence found and/or method applied in restoring or reestablishing corner:


No evidence of original B.T.s found.  
Found monument as described above and the following bearing trees:  
Red Pine 10" S 46 1/2° E 32.60 feet  
Red Pine 12" N 58° W 34.84 feet

Corner record research on file with County Representative.

C. Description of monument for corner and accessories established to perpetuate locating the position of the corner:

Blazed and scribed the following new bearing trees: (All measurements taken to a nail in side of tree)  
Balsam 6" N 41° E 31.74 feet  
Red Pine 7" S 45° W 38.21 feet  
Steel sign post North 0.8 feet

99-55  
Signed by Gary L. Pisoni Date 12-28-99  
Surveyor's Michigan License No. 27457

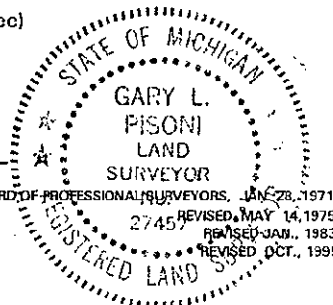

FORM APPROVED BY MICHIGAN STATE BOARD OF PROFESSIONAL SURVEYORS, JAN 28, 1971  
REVISED, MAY 14, 1975  
REVISED JAN., 1983  
REVISED OCT., 1995