

RF

MAR 9 2000

SECTION

LAND CORNER RECORDATION CERTIFICATE
Filing Requirement of Act 74, Mich. P.A. 1970

For corners in

Form with fields for Iron (County), Located In: T 43N R 32W, Corner Code # F-7, and sections 1-3 for Public Land Survey, Property Controlling, and Miscellaneous.

IRON COUNTY MICHIGAN RECEIVED FOR RECORD

99 DEC 30 AM 10: 21

Handwritten signature and initials: L.C. Records, L.S., P. 66

Register of Deeds Stamp & File Number

4. Lot No. , Recorded Plat
5. Private Claims

Quarter Corner to Sections 16 and 21, T43N, R32W

I, Gary L. Pisoni, in a field survey on November 1, 1999 do hereby state that under requirements of P.A. 74, Michigan P.A. of 1970, the corner points mentioned in lines 1 and 2 above were in conformance with regulations and rules therefore as required in the current manual of survey instructions of the United States Department of the Interior, Bureau of Land Management or by a decree of a Court of Law and /or that the corner points mentioned in lines 3, 4 and 5 above were in conformance with the rules of the Michigan Board of Land Surveyors or by a Decree of a Court of Law; established, re-established, monumented, recovered, found as expressed below:

NOTE: Not more than 2 corners, all in the same town and range, may be recorded on this certificate.

Grid table with columns A-M and rows 1-13, containing numbers 1-36.

A. Description of original monument and accessories and/or subsequent restoration:

Original corner established on August 6, 1849 by Z. B. Searls, U.S. Deputy Surveyor. Original Corner; Spruce Wood Post Original Bearing Trees:

Yellow Birch 8" S 70° E 13 lks (8.58 feet)
Yellow Birch 10" N 60° W 17 lks (11.22 feet)

PEER GROUP APPROVED
Iron Gary L. Pisoni 12-21-99
COUNTY REPRESENTATIVE

B. Description of corner evidence found and/or method applied in restoring or reestablishing corner:

No evidence of original B.T.s found.


Found a concrete monument on line and at midpoint between the Southwest and Southeast Section corners of Section 16. Monument had been damaged and bent from a bulldozer. Monument is located on the North edge of a railroad grade.

Corner record research on file with County Representative.

C. Description of monument for corner and accessories established to perpetuate locating the position of the corner:

At the corner position, replaced concrete monument with a 2" diameter by 30" long split base aluminum pipe monument, with a 3" dia. aluminum cap stamped as follows: Iron County Remonumentation, T43N, R32W, 1/4, S-16, S-21, 1999, RLS 27457 from which I established the following new blazed and scribed bearing trees:(All measurements taken to a nail in side of tree)

Black Spruce 5" N 05° E 14.22 feet
Black Spruce 6" S 46° E 41.81 feet
Red Pine 12" S 25° W 36.70 feet
Red Pine 13" N 54° W 52.25 feet
Steel sign post N 20° W 0.90 feet

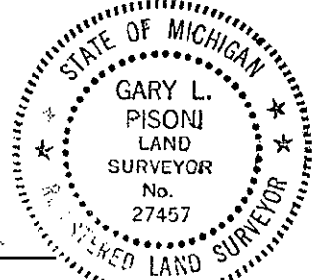

99-66
Signed by Gary L. Pisoni Date 12-28-99
Surveyor's Michigan License No. 27457

FORM APPROVED BY MICHIGAN STATE BOARD OF PROFESSIONAL SURVEYORS, JAN. 28, 1971
REVISED MAY 14, 1975
REVISED JAN., 1983
REVISED OCT., 1995