

**SURVEY &
REMONUMENTATION**

JAN 19 1999

SECTION

**LAND CORNER RECORDATION CERTIFICATE
Filing Requirement of Act 74, Mich. P.A. 1970**

For corners in

<u>Iron</u> (County)	Located in:	Corner Code #
1. Public Land Survey	T <u>43N</u> R <u>32W</u>	<u>G-10</u>
	T _____ R _____	_____
	T _____ R _____	_____
	T _____ R _____	_____
2. Property Controlling in Section	S _____ T _____ R _____	_____
	S _____ T _____ R _____	_____
3. Miscellaneous Property in Sec.	S _____ T _____ R _____	_____
	S _____ T _____ R _____	_____

IRON COUNTY
MICHIGAN
RECEIVED FOR RECORD

98 DEC 28 AM 11:11
L.C. Record: L. 7, P. 241
Gail... [Signature]
REGISTERED LAND SURVEYORS

Register of Deeds Stamp & File Number

4. Lot No. _____, Recorded Plat _____
5. Private Claims _____

Quarter Corner Sections 28 and 27, T43N, R32W

I, Gary L. Pisoni, in a field survey on October 22, 1998, do hereby state that under requirements of P.A. 74, Michigan P.A. of 1970, the corner points mentioned in lines 1 and 2 above were in conformance with regulations and rules therefore as required in the current manual of survey instructions of the United States Department of the Interior, Bureau of Land Management or by a decree of a Court of Law and /or that the corner points mentioned in lines 3, 4 and 5 above were in conformance with the rules of the Michigan Board of Land Surveyors or by a Decree of a Court of Law; established, re-established, monumented, recovered, found as expressed below:

	A	B	C	D	E	F	G	H	I	J	K	L	M
1													
2	6			5			4			3		2	1
3													
4	7			8			9			10		11	12
5													
6	18			17			16			15		14	13
7													
8	19			20			21			22		23	24
9													
10	30			29			28			27		26	25
11													
12	31			32			33			34		35	36
13													

NOTE: Not more than 2 corners, all in the same town and range, may be recorded on this certificate.

A. Description of original monument and accessories and/or subsequent restoration:

Original corner established on August 25, 1849 by Zelotes B. Searls, U.S. Deputy Surveyor.

Original Corner; White Pine Post
Original Bearing Trees:

Cedar	10"	S 40°E	18 lks (11.88 feet)
Yellow Pine	20"	N 20°W	28 lks (18.48 feet)

On 4-7-75, Donald D. Lappala, RLS found a 1 1/2" diameter iron pipe set in concrete. At record bearing and distance from said pipe found the stump remains of a Red Pine bearing tree. Corner position verified further by retracement measurement of the section line North from corner to record natural features and record line tree; recorded in L.C. Certificate Liber 1, Pages 317-318 on 4/23/75.

1975 Bearing Trees:

Red Pine	5"	N 27°W	76.7 feet
Red Pine	6"	N 13°E	64.5 feet
Red Pine	18"	S 38°E	29.5 feet

B. Description of corner evidence found and/or method applied in restoring or reestablishing corner:

No evidence of original B.T.s found.

Found iron pipe as described above and the following bearing trees:

Red Pine	14"	N 26° W	76.02 feet
Red Pine	14"	N 06° E	64.43 feet
Red Pine	24"	S 35° E	29.52 feet

PEER GROUP APPROVED
Gary L. Pisoni 11-24-98
COUNTY REPRESENTATIVE

Corner record research on file with county representative.


Iron pipe is 12" above ground surface.

C. Description of monument for corner and accessories established to perpetuate locating the position of the corner:

Set a 3/4" diameter rod monument inside of iron pipe with a 3" diameter aluminum cap stamped as follows: Iron County Remonumentation, T43N, R32W, 1/4, S-27, S-28, 1998, RLS 27457 from which I established the following new corner reference:

Steel sign post East 0.80 feet

98-7
Signed by Gary L. Pisoni Date 12-21-98
Surveyor's Michigan License No. 27457

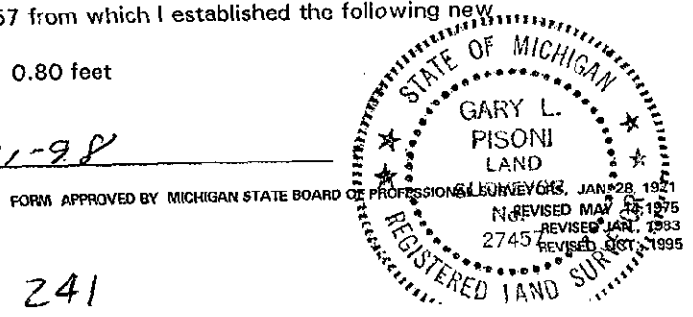

L. 7 P. 241