

MAR 09 2000

SECTION

LAND CORNER RECORDATION CERTIFICATE  
Filing Requirement of Act 74, Mich. P.A. 1970

For corners in

Iron	Located In:	Corner Code #
(County)		
1. Public Land Survey	T <u>43N</u> R <u>32W</u>	<u>1-9</u>
	T _____ R _____	_____
	T _____ R _____	_____
	T _____ R _____	_____
2. Property Controlling in Section	S _____ T _____ R _____	_____
	S _____ T _____ R _____	_____
3. Miscellaneous Property in Sec.	S _____ T _____ R _____	_____
	S _____ T _____ R _____	_____

IRON COUNTY  
MICHIGAN  
RECEIVED FOR RECORD

99 DEC 30 AM 10:24  
L.C. Records: L.S. P. 83


*Gary L. Pisoni*  
REGISTERED LAND SURVEYOR

Register of Deeds Stamp & File Number

4. Lot No. \_\_\_\_\_, Recorded Plat \_\_\_\_\_  
5. Private Claims \_\_\_\_\_

Section Corner to Sections 22, 23, 26, 27, T43N, R32W

I, Gary L. Pisoni, in a field survey on Oct. 26, 1999 do hereby state that under requirements of P.A. 74, Michigan P.A. of 1970, the corner points mentioned in lines 1 and 2 above were in conformance with regulations and rules therefore as required in the current manual of survey instructions of the United States Department of the Interior, Bureau of Land Management or by a decree of a Court of Law and /or that the corner points mentioned in lines 3, 4 and 5 above were in conformance with the rules of the Michigan Board of Land Surveyors or by a Decree of a Court of Law; established, re-established, monumented, recovered, found as expressed below:

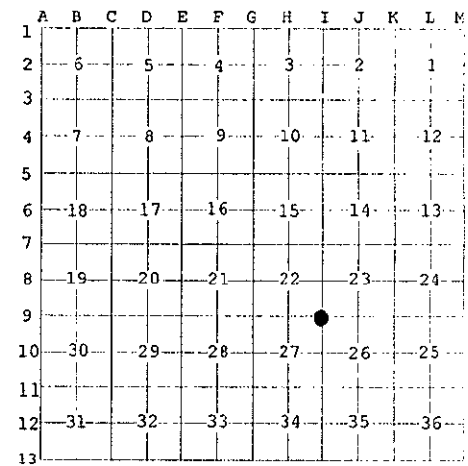

NOTE: Not more than 2 corners, all in the same town and range, may be recorded on this certificate.

A. Description of original monument and accessories and/or subsequent restoration:

Original corner established on August 23, 1849 by Z. B. Searls, U.S. Deputy Surveyor.  
Original Corner; Hemlock Wood Post  
Original Bearing Trees:

Hemlock	28"	S 10° W	6 lks (3.96 feet)
Cedar	18"	N 51° E	40 lks (26.40 feet)

PEER GROUP APPROVED  
*Iron County Rep. 12-21-99*  
COUNTY REPRESENTATIVE

B. Description of corner evidence found and/or method applied in restoring or reestablishing corner:

No evidence of original B.T.s found.

Found a 3/4" diameter iron pipe marking corner position. Iron pipe is consistent with GLO distances to the North, South and East. Found existing bearing trees facing corner position:

Red Maple	4"	S 65° E	9.44 feet
Sugar Maple	12"	N 58° W	22.16 feet

I accept the iron pipe as the best available evidence for restoring the corner position.

Corner record research on file with County Representative.

C. Description of monument for corner and accessories established to perpetuate locating the position of the corner:

Inside the iron pipe, set a 5/8" diameter by 30" long rebar with a 3" diameter aluminum cap stamped as follows: Iron County Remonumentation, T43N, R32W, S-22, S-23, S-26, S-27, 1999, RLS 27457 from which I established the following new blazed and scribed bearing trees: (All measurements taken to a nail in side of tree)

Red Maple	5"	N 41° E	42.64 feet
Sugar Maple	6"	S 63° W	5.92 feet
Steel sign post		North	0.30 feet



99-83  
Signed by Gary L. Pisoni Date 12-28-99  
Surveyor's Michigan License No. 27457