

MAR 09 2000

SECTION

LAND CORNER RECORDATION CERTIFICATE
Filing Requirement of Act 74, Mich. P.A. 1970

For corners in

Form with fields for County (Iron), Located In (T43N R32W), Corner Code # (I-10), and survey types (Public Land Survey, Property Controlling, Miscellaneous).

IRON COUNTY MICHIGAN RECEIVED FOR RECORD

99 DEC 30 AM 10:25

L.C. Records: L, S, P. 87

Handwritten signature and name of County Representative.

Register of Deeds Stamp & File Number

4. Lot No. , Recorded Plat
5. Private Claims

Quarter Corner to Section 26 and 27, T43N, R32W

I, Gary L. Pisoni, in a field survey on Nov. 9, 1999 do hereby state that under requirements of P.A. 74, Michigan P.A. of 1970, the corner points mentioned in lines 1 and 2 above were in conformance with regulations and rules therefore as required in the current manual of survey instructions of the United States Department of the Interior, Bureau of Land Management or by a decree of a Court of Law and/or that the corner points mentioned in lines 3, 4 and 5 above were in conformance with the rules of the Michigan Board of Land Surveyors or by a Decree of a Court of Law; established, re-established, monumented, recovered, found as expressed below:

Grid table with columns A-M and rows 1-13, showing a diamond symbol at the intersection of row 10 and column I.

NOTE: Not more than 2 corners, all in the same town and range, may be recorded on this certificate.

A. Description of original monument and accessories and/or subsequent restoration:

Original corner established on August 23, 1849 by Z. B. Searls, U.S. Deputy Surveyor. Original Corner; Cedar Wood Post

Original Bearing Trees:

Table listing bearing trees: Cedar 8" S 72° W 20 lks (13.20 feet) and Cedar 10" N 55° E 10 lks (6.60 feet).

PEER GROUP APPROVED

Iron Gary L. Pisoni 12-21-99

COUNTY REPRESENTATIVE

B. Description of corner evidence found and/or method applied in restoring or reestablishing corner:

No evidence of original B.T.s found.


Found a 1 1/2" diameter iron pipe marking the corner position. Iron pipe is consistent with GLO distances North and South. I accept the iron pipe as the best available evidence for restoring the corner position.

Corner record research on file with County Representative.

C. Description of monument for corner and accessories established to perpetuate locating the position of the corner:

Inside the iron pipe, set a 5/8" diameter by 30" long rebar with a 3" diameter aluminum cap stamped as follows: Iron County Remonumentation, T43N, R32W, 1/4, S-26, S-27, 1999, RLS 27457 from which I established the following new blazed and scribed bearing trees: (All measurements taken to a nail in side of tree)

Table listing new bearing trees: Cedar 14" N 10° E 3.10 feet, Cedar 7" S 83° E 32.60 feet, Cedar 11" S 01° E 17.26 feet, Cedar 8" S 64° W 42.56 feet, Steel sign post N 61° W 0.90 feet.

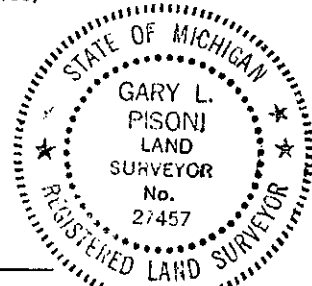

99-87

Signed by Gary L. Pisoni Date 12-28-99

Surveyor's Michigan License No. 27457

FORM APPROVED BY MICHIGAN STATE BOARD OF PROFESSIONAL SURVEYORS, JAN. 28, 1971 REVISED MAY 14, 1975 REVISED JAN., 1983 REVISED OCT., 1995