

MAR 09 2000

SECTION

LAND CORNER RECORDATION CERTIFICATE
Filing Requirement of Act 74, Mich. P.A. 1970

For corners in

Form with fields for County (Iron), Located In (T 43N R 32W), Corner Code # (I-12), and categories: 1. Public Land Survey, 2. Property Controlling in Section, 3. Miscellaneous Property in Sec.

IRON COUNTY MICHIGAN RECEIVED FOR RECORD

99 DEC 30 AM 10:25
L.C. Records: 2, 8, P. 91
[Signature]

Register of Deeds Stamp & File Number

4. Lot No. , Recorded Plat
5. Private Claims

Quarter Corner to Sections 34 and 35, T43N, R32W

I, Gary L. Pisoni, in a field survey on Sept. 28, 1999 do hereby state that under requirements of P.A. 74, Michigan P.A. of 1970, the corner points mentioned in lines 1 and 2 above were in conformance with regulations and rules therefore as required in the current manual of survey instructions of the United States Department of the Interior, Bureau of Land Management or by a decree of a Court of Law and /or that the corner points mentioned in lines 3, 4 and 5 above were in conformance with the rules of the Michigan Board of Land Surveyors or by a Decree of a Court of Law; established, re-established, monumented, recovered, found as expressed below:

NOTE: Not more than 2 corners, all in the same town and range, may be recorded on this certificate.

Grid table with columns A-M and rows 1-13, containing numbers 1-36.

A. Description of original monument and accessories and/or subsequent restoration:

Original corner established on August 23, 1849 by Z. B. Searls, U.S. Deputy Surveyor.
Original Corner; Cedar Wood Post
Original Bearing Trees:
Yellow Birch 18" S 77° E 20 lks (13.20 feet)
Cedar 16" N 74° W 17 lks (11.22 feet)

PEER GROUP APPROVED
Iron Gary L. Pisoni 12-28-99
COUNTY REPRESENTATIVE

B. Description of corner evidence found and/or method applied in restoring or reestablishing corner:

No evidence of original B.T.s found.


Found a 1" diameter iron bolt marking the corner position. Iron bolt is located in line with the centerline of a county road running West and South. Iron bolt is consistent with GLO distances North and South. I accept the iron bolt as the best available evidence for restoring the corner position.

Corner record research on file with County Representative.

C. Description of monument for corner and accessories established to perpetuate locating the position of the corner:

Over the top of the iron bolt, set a 2" diameter by 30" long split base aluminum pipe monument, with a 3" dia. aluminum cap stamped as follows: Iron County Remonumentation, T43N, R32W, 1/4, S-34, S-35, 1999, RLS 27457 from which I established the following new blazed and scribed bearing trees:(All measurements taken to a nail in side of tree)

Spruce 14" N 85° E 16.80 feet
Red Maple 12" S 54° E 56.55 feet
Cherry 7" S 38° W 82.03 feet
Tamarack 14" N 34° W 21.65 feet
Steel sign post North 1.30 feet

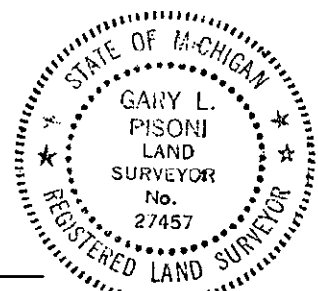

99-91
Signed by Gary L. Pisoni Date 12-28-99

Surveyor's Michigan License No. 27457

FORM APPROVED BY MICHIGAN STATE BOARD OF PROFESSIONAL SURVEYORS, JAN. 28, 1971
REVISED MAY 14, 1975
REVISED JAN., 1983
REVISED OCT., 1995