

MAR 9 2000

SECTION

LAND CORNER RECORDATION CERTIFICATE
Filing Requirement of Act 74, Mich. P.A. 1970

For corners in

Form with fields for Iron (County), Located In: T 43N R 32W, Corner Code #: L-5, and numbered sections 1-5 for survey details.

IRON COUNTY MICHIGAN RECEIVED FOR RECORD

99 DEC 30 AM 10:19

Handwritten signature and name: L.C. Records L.S., P. 61

Register of Deeds Stamp & File Number

4. Lot No. ... Recorded Plat ...
5. Private Claims ...

Quarter Corner to Sections 12 and 13, T43N, R32W

I, Gary L. Pisoni, in a field survey on October 5, 1999, do hereby state that under requirements of P.A. 74, Michigan P.A. of 1970, the corner points mentioned in lines 1 and 2 above were in conformance with regulations and rules therefore as required in the current manual of survey instructions of the United States Department of the Interior, Bureau of Land Management or by a decree of a Court of Law and /or that the corner points mentioned in lines 3, 4 and 5 above were in conformance with the rules of the Michigan Board of Land Surveyors or by a Decree of a Court of Law; established, re-established, monumented, recovered, found as expressed below:

NOTE: Not more than 2 corners, all in the same town and range, may be recorded on this certificate.

Grid table with columns A-M and rows 1-13, containing numbers 1-36.

A. Description of original monument and accessories and/or subsequent restoration:

Original corner established on August 3, 1849 by Zelotes B. Searls, U.S. Deputy Surveyor.
Original Corner: Spruce Post
Original Bearing Trees:

Table with 4 columns: Tree type, Diameter, Bearing, Distance. Includes Spruce 6" S 51° E 35 lks (23.10 feet) and Spruce 4" N 45° W 15 lks (9.90 feet).

PEER GROUP APPROVED

Iron Gary L. Pisoni 12-21-99
COUNTY REPRESENTATIVE

B. Description of corner evidence found and/or method applied in restoring or reestablishing corner:

No evidence of original B.T.s found. Found a 3" diameter wood post marking corner position.


Wood post located near the centerline of a power line. Distances East and West are consistent with GLO distances. I accept the wood post as the best available evidence for restoring the corner position.

Corner record research on file with County Representative.

C. Description of monument for corner and accessories established to perpetuate locating the position of the corner:

At the corner position, replaced wood post and set a 3/4" diameter aluminum rod monument, 3 feet long and 2" above ground surface with a 3" diameter aluminum cap stamped as follows: Iron County Remonumentation, T43N, R32W, 1/4, S-12, S-13, 1999, RLS 27457 from which I established the following new blazed and scribed bearing trees: (All measurements taken to a nail in side of tree)

Table with 4 columns: Tree type, Diameter, Bearing, Distance. Includes Cedar 6" N 27° E 46.35 feet, Black Spruce 8" N 83° E 32.45 feet, Black Spruce 4" S 36° W 66.94 feet, Black Spruce 6" S 74° W 56.95 feet, and Steel sign post S 14° E 0.62 feet.

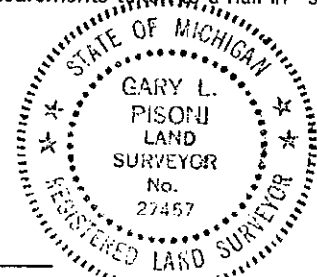

99-61

Signed by Gary L. Pisoni Date 12-28-99

Surveyor's Michigan License No. 27457

FORM APPROVED BY MICHIGAN STATE BOARD OF PROFESSIONAL SURVEYORS, JAN. 28, 1971
REVISED MAY 14, 1975
REVISED JAN., 1983
REVISED OCT., 1995