

**LAND CORNER RECORDATION CERTIFICATE**  
**Filing Requirement of Act 74, Mich. P.A. 1970 as Amended**

For corners in

Iron	Located In:	Corner Code #
<small>(County)</small>		
1. Public Land Survey	T <u>43N</u> R <u>32W</u>	<u>L11</u>
	T <u>43N</u> R <u>32W</u>	<u>M12</u>
	T _____ R _____	_____
2. Property Controlling in Section	S _____ T _____ R _____	_____
	S _____ T _____ R _____	_____
3. Miscellaneous Property in Sec.	S _____ T _____ R _____	_____
	S _____ T _____ R _____	_____

Register of Deeds Stamp & File Number

4. Lot No. \_\_\_\_\_, Recorded Plat \_\_\_\_\_  
 5. Private Claims

M12 Apr 04 2005  
 L11 Mar 29 2005

	A	B	C	D	E	F	G	H	I	J	K	L	M
1													
2	6		5		4		3		2		1		
3													
4	7		8		9		10		11		12		
5													
6	18		17		16		15		14		13		
7													
8	19		20		21		22		23		24		
9													
10	30		29		28		27		26		25		
11													
12	31		32		33		34		35		36		
13													

I, Stephan J. Szyszkoski, in a field survey on \_\_\_\_\_, 20\_\_\_\_ do hereby state that under requirements of P.A. 74, Michigan P.A. of 1970, the corner points mentioned in lines 1 and 2 above were in conformance with regulations and rules therefore as required in the current manual of survey instructions of the United States Department of the Interior, Bureau of Land Management or by a decree of a Court of Law and /or that the corner points mentioned in lines 3, 4 and 5 above were in conformance with the rules of the Michigan Board of Land Surveyors or by a Decree of a Court of Law; established, re-established, monumented, recovered, found as expressed below:

**NOTE: Not more than 2 corners, all in the same town and range, may be recorded on this certificate.**

**A. Description of original monument and accessories and/or subsequent restoration:**


(L11) Quarter corner common to Sections 25 and 36. 1849: Established by Z.B.Searles, Deputy Surveyor. Set Heml. Qr. Sect. post. Tam 16 S44W 20 links, W.Pine 18 N45E 13 links. 1976: Monumented and recorded by A.O.Enger, RLS at the position of a found iron pipe. The monumented 1976 position was found at odds with the remains of the original 8Ts, both recovered by Mr. Enger. Notwithstanding, Mr. Enger accepted the position of the pipe. See the 1976 record for more detail.  
 (M12) Quarter corner common to Section 36 T43N-R32W and Section 31 T43N-R31W. 1972: Reestablished by A.O.Enger RLS midway and on line between Section corners 40.102 chains north and south. Set 1"IDx36" I.pipe with 4" aluminum cap. J.Pine 10 N51E 12.3' J.Pine 10 S73 1/2W 13.1'.

**B. Description of corner evidence found and/or method applied in restoring or reestablishing corner:**

(L11) Recovered but did not accept the 1976 monument. Remonumented the corner at record bearing and distance from the stump remains of the original 8T W.Pine and Tamarack, both recovered in poor condition with no markings visible. From the position thus remonumented, the 1976 monument bears S44W (true) 4.6' distant. Destroyed the 1976 monument.  
 (M12) Recovered the 1972 monument, plumb and set firmly, cap broken, at record bearing and distance from the 1972 witnesses, both now cut stumps with lower blazes plain. Verified the position of the monument with respect to the adjacent section corners and accepted same as a careful and faithful reestablishment of the position of the original corner. Placed a new 4" dia. alum. cap in the existing pipe and made new witnesses.

**C. Description of monument for corner and accessories established to perpetuate locating the position of the corner:**

(L11) Set 1"IDx32" I.pipe with 4" alum. MDNR cap. Set measuring nails in:	(M12) Found 1"ID I.pipe with broken cap. Placed 4" alum. MDNR cap in existing pipe. Set measuring nails in:
6" Spruce N04E 14.8' mrkd "1/4S NBT"	10" W.Pine N30E 60.7' mrkd "1/4S NBT"
11" W.Pine N48E 20.3' do *	8" R.Pine S24E 116.8' do
9" Oak S43E 47.0' do	22" R.Pine S50W 83.9' do
7" Maple S02E 26.9' do	16" W.Pine N74W 88.4' do
Fd. sq'd cedar post S50W 4.4' Bearings are magnetic. Distances are to nail with MDNR tag. * denotes NBT originally marked in 1976.	Sq'd cedar post adjacent. Bearings are magnetic. Distances are to nail with MDNR tag.

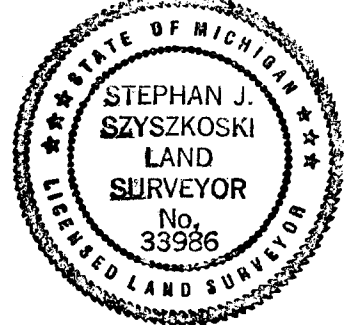

Signed by Stephan J. Szyszkoski  
 Surveyor's Michigan License No. 33986

Date 4/7/05

For the Michigan Department of Natural Resources, Office of Land and Facilities