LAND CORNER RECORDATION CERTIFICATE
Filing Requirement of Act 74, Mich. P.A. 1970 as Amended

For corners in

Iron (County)

		Located In:		Corner Code #
1. Public Land Survey		T 43N	R 32W	L13
		T	R	
		T	R	
	S	T	R	
2. Property Controlling	S 36	T 43N	R 32W	6
in Section	S	T	R	
3. Miscellaneous	S	T	R	
Property in Sec.	S	T	R	

Register of Deeds Stamp & File Number

4. Lot No. _____ , Recorded Plat_____

5. Private Claims

6 Apr 06 2005
L13 Apr 05 2005

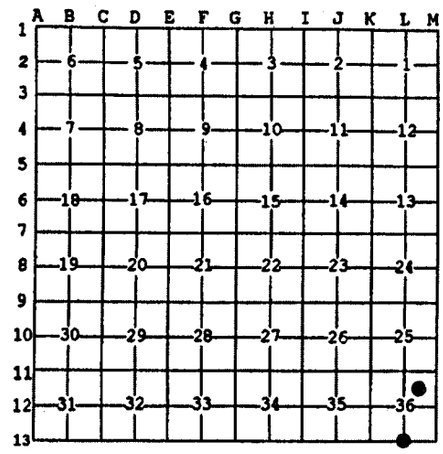

I, Stephan J. Szyszkoski, in a field survey on _____, 20 ____ do hereby state that under requirements of P.A. 74, Michigan P.A. of 1970, the corner points mentioned in lines 1 and 2 above were in conformance with regulations and rules therefore as required in the current manual of survey instructions of the United States Department of the Interior, Bureau of Land Management or by a decree of a Court of Law and /or that the corner points mentioned in lines 3, 4 and 5 above were in conformance with the rules of the Michigan Board of Land Surveyors or by a Decree of a Court of Law; established, re-established, monumented, recovered, found as expressed below:

NOTE: Not more than 2 corners, all in the same town and range, may be recorded on this certificate.

A. Description of original monument and accessories and/or subsequent restoration:

(L13) Quarter corner common to Section 36 T43N-R32W and Section 1 T42N-R32W. 1976: Remonumented and recorded by A.O.Enger, RLS at the position of a 1"x63" iron pipe found at record bearing and distance from remains of what Mr. Enger described as "probable" original BT Cedar 4 N53E 7 links. Set 1"IDx36" Iron pipe with 4" aluminum cap. Cedar 7 N75W 5.2', Cedar 5 N68E 4.9'.
(6-Sec. 36) Northeast 1/16 corner, Section 36. Not established in the original survey.

B. Description of corner evidence found and/or method applied in restoring or reestablishing corner:

(L13) Recovered the 1976 monument in good condition and at record bearing and distance from the 1976 Cedar NBTs, both found in good condition. The 1976 NBTs were subsequently cut down to facilitate GPS observations at the corner position. Left the monument in place and made new witnesses as described below.
(6-Sec. 36) Established the corner at the intersection of straight lines connecting opposite 1/16 corners.

C. Description of monument for corner and accessories established to perpetuate locating the position of the corner:

(L13) Found 1"ID I.pipe with 4" alum. MDNR cap. Set measuring nails in:
6" Cedar N20E 6.4' mrkd "1/4S NBT"
7" Cedar N72W 11.6' do
11" Cedar S07W 28.1' do
7" Cedar S67E 18.8' do
Set sq'd cedar post adjacent. Bearings are magnetic. Distances are to nail with MDNR tag.

(6) Set 1"IDx32" I.pipe with 4" alum. MDNR cap. Set measuring nails in:
6" J.Pine S67E 9.8' mrkd "1/16S BT"
6" Balsam S60W 50.8' do
7" Balsam N56W 68.6' do
4" Balsam N34W 43.7' do
Set sq'd cedar post adjacent. Bearings are magnetic. Distances are to nail with MDNR tag.

STATE OF MICHIGAN
STEPHAN J. SZYSZKOSKI
LAND SURVEYOR
No. 33986
LICENSED LAND SURVEYOR

Signed by Stephan J. Szyszkoski Date 4/7/05

Surveyor's Michigan License No 33986

For the Michigan Department of Natural Resources, Office of Land and Facilities

FORM APPROVED BY MICHIGAN STATE BOARD OF PROFESSIONAL SURVEYORS, JAN. 28, 1971
Revised May 14, 1975
Revised Jan., 1983
Revised Oct., 1995