

LAND CORNER RECORDATION CERTIFICATE
Filing Requirement of Act 74, Mich. P.A. 1970 as Amended

For corners in

<u>Iron</u> (County)	Located In:	Corner Code #
1. Public Land Survey	T <u>43N</u> R <u>32W</u>	<u>M11</u>
	T _____ R _____	_____
	T _____ R _____	_____
	S _____ T _____ R _____	_____
2. Property Controlling in Section	S <u>36</u> T <u>43N</u> R <u>32W</u>	<u>9</u>
	S _____ T _____ R _____	_____
3. Miscellaneous Property in Sec.	S _____ T _____ R _____	_____
	S _____ T _____ R _____	_____

Register of Deeds Stamp & File Number

4. Lot No. _____, Recorded Plat _____
 5. Private Claims

9 Apr 05 2005
 M11 Apr 04 2005

I, Stephan J. Szyszkoski, in a field survey on _____, 20____ do hereby state that under requirements of P.A. 74, Michigan P.A. of 1970, the corner points mentioned in lines 1 and 2 above were in conformance with regulations and rules therefore as required in the current manual of survey instructions of the United States Department of the Interior, Bureau of Land Management or by a decree of a Court of Law and /or that the corner points mentioned in lines 3, 4 and 5 above were in conformance with the rules of the Michigan Board of Land Surveyors or by a Decree of a Court of Law; established, re-established, monumented, recovered, found as expressed below:

	A	B	C	D	E	F	G	H	I	J	K	L	M
1													
2		6		5		4		3		2		1	
3													
4		7		8		9		10		11		12	
5													
6		18		17		16		15		14		13	
7													
8		19		20		21		22		23		24	
9													
10		30		29		28		27		26		25	
11													
12		31		32		33		34		35		36	
13													

NOTE: Not more than 2 corners, all in the same town and range, may be recorded on this certificate.

A. Description of original monument and accessories and/or subsequent restoration:


(M11) Corner common to Sections 25-36 T43N-R32W and 30-31 T43N-R31W. 2000: Approved by Iron County Remonumentation Peer Review Group and recorded in Liber 8 of LCRC Page 272, Iron County Records. 1" dia.x36" iron pipe with 4" dia. aluminum cap placed by A.O.Enger, RLS in 1972. Latest witnesses of record: J.Pine 9" N16E 44.15', J.Pine 14" N64E 12.89', Balsam 8" S44W 4.68', J.Pine 9" N12W 78.35', Steel sign post West 0.85'.
 (9-Sec. 36) East 1/16 corner, Section 36. Not established in the original survey.

B. Description of corner evidence found and/or method applied in restoring or reestablishing corner:

(M11) Recovered the 1972 monument as described and recorded in the 2000 record, in good condition, and at record bearing and distance from the witnesses of record. The Jack Pines N16E and N12W are in good condition. the J.Pine N64E and Balsam S44W are now cut stumps. The steel sign post is in place at record bearing and distance. Left the monument in place and made two new witnesses as described below.
 (9-Sec. 36) Established the corner midway and on a straight line between Center of Section 1315.26' West and Quarter corner 1315.26' East.

C. Description of monument for corner and accessories established to perpetuate locating the position of the corner:

(M11) Found 1" ID I.pipe with 4" alum. MDNR cap. Set measuring nails in: 12" R.Pine N86E 119.4' mrkd "S30 NBT" 12" R.Pine S51E 140.9' "S31 NBT" Bearings are magnetic. Distances are to nail with MDNR tag.	(9) Set 1" IDx32" I.pipe with 4" alum. MDNR cap. Set measuring nails in: 4" Tamarack N57E 17.8' mrkd "1/16S BT" 6" B.Spruce S48E 21.1' do 5" B.Spruce S40W 11.9' do 11" Tamarack N78W 28.0' do Set sq'd cedar post adjacent. Bearings are magnetic. Distances are to nail with MDNR tag.
---	--

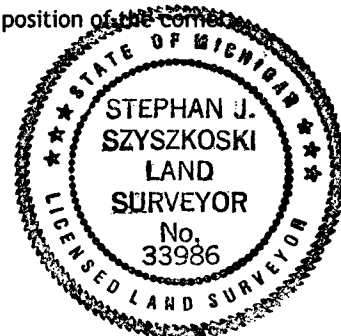

Signed by Stephan J. Szyszkoski
 Surveyor's Michigan License No. 33986

Date 4/7/05

For the Michigan Department of Natural Resources, Office of Land and Facilities