

**LAND CORNER RECORDATION CERTIFICATE**  
**Filing Requirement of Act 74, Mich. P.A. 1970 as Amended**

For corners in

<u>Iron</u> <small>(County)</small>	Located In:	Corner Code #	
1. Public Land Survey	T ___ R ___	_____	
	T ___ R ___	_____	
	T ___ R ___	_____	
	S ___ T ___ R ___	_____	
2. Property Controlling in Section	S <u>36</u> T <u>43N</u> R <u>32W</u>	<u>7</u>	
	S ___ T ___ R ___	_____	
3. Miscellaneous Property in Sec.	S ___ T ___ R ___	_____	
	S ___ T ___ R ___	_____	
4. Lot No. _____, Recorded Plat _____			
5. Private Claims			

Register of Deeds Stamp & File Number

	A	B	C	D	E	F	G	H	I	J	K	L	M
1													
2	6	5	4	3	2	1							
3													
4	7	8	9	10	11	12							
5													
6	18	17	16	15	14	13							
7													
8	19	20	21	22	23	24							
9													
10	30	29	28	27	26	25							
11													
12	31	32	33	34	35	36							
13													

Apr 06 2005

I, Stephan J. Szyszkoski, in a field survey on \_\_\_\_\_, 20\_\_\_\_ do hereby state that under requirements of P.A. 74, Michigan P.A. of 1970, the corner points mentioned in lines 1 and 2 above were in conformance with regulations and rules therefore as required in the current manual of survey instructions of the United States Department of the Interior, Bureau of Land Management or by a decree of a Court of Law and /or that the corner points mentioned in lines 3, 4 and 5 above were in conformance with the rules of the Michigan Board of Land Surveyors or by a Decree of a Court of Law; established, re-established, monumented, recovered, found as expressed below:

**NOTE: Not more than 2 corners, all in the same town and range, may be recorded on this certificate.**

A. Description of original monument and accessories and/or subsequent restoration:


(7-Sec. 36) North 1/16 corner between Section 36 T43N-R32W and Section 31 T43N-R31W. 1976: Established and monumented by A.O. Enger, RLS midway and on line between Section and Quarter corner. Set 1"IDx36" I.pipe with 4" aluminum cap. J.Pine 6" S33W 62.5', J.Pine 5 N03E 76.3'.

B. Description of corner evidence found and/or method applied in restoring or reestablishing corner:

(7-Sec. 36) Recovered the 1976 monument in good condition and at record bearing and distance from the 1976 J.Pine NBTs. The J.Pine NE is dying, with overgrown blazes. The J.Pine SW is dead and down, scribing visible.

C. Description of monument for corner and accessories established to perpetuate locating the position of the corner:

(7) Found 1"ID I.pipe with 4" alum. MDNR cap. Set measuring nails in:  
 12" R.Pine N37E 28.2' mrkd "1/16S BT"  
 12" R.Pine S22E 41.7' do  
 3" twin Cherry S47W 18.3' do  
 10" W.Spruce N26W 48.8' do  
 Set sq'd cedar post adjacent. Bearings are magnetic. Distances are to nail with MDNR tag.

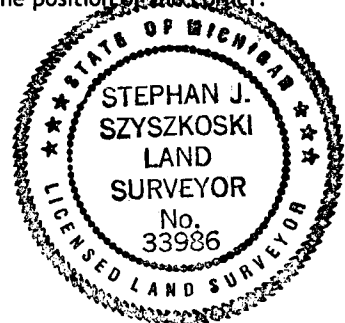

Signed by Stephan J. Szyszkoski  
 Surveyor's Michigan License No. 33986

Date 4/7/05

For the Michigan Department of Natural Resources, Office of Land and Facilities