

LAND CORNER RECORDATION CERTIFICATE
 Filing Requirement of Act 74, Mich. P.A. 1970 as Amended

For corners in

Iron	Located In:	Corner Code #
(County)		
1. Public Land Survey	T 43N R 32W	K3
	T 43N R 32W	I5
	T _____ R _____	_____
2. Property Controlling in Section	S _____ T _____ R _____	_____
	S _____ T _____ R _____	_____
	S _____ T _____ R _____	_____
3. Miscellaneous Property in Sec.	S _____ T _____ R _____	_____
	S _____ T _____ R _____	_____
4. Lot No. _____, Recorded Plat _____		
5. Private Claims		

Register of Deeds Stamp & File Number

A	B	C	D	E	F	G	H	I	J	K	L	M
1												
2	6	5	4	3	2	1						
3												
4	7	8	9	10	11	12						
5												
6	18	17	16	15	14	13						
7												
8	19	20	21	22	23	24						
9												
10	30	29	28	27	26	25						
11												
12	31	32	33	34	35	36						
13												

I, Stephan J. Szyszkoski, in a field survey on K3 02/09/2010 and I5 02/11/2010 do hereby state that under requirements of P.A. 74, Michigan P.A. of 1970, the corner points mentioned in lines 1 and 2 above were in conformance with regulations and rules therefore as required in the current manual of survey instructions of the United States Department of the Interior, Bureau of Land Management or by a decree of a Court of Law and /or that the corner points mentioned in lines 3, 4 and 5 above were in conformance with the rules of the Michigan Board of Land Surveyors or by a Decree of a Court of Law; established, re-established, monumented, recovered, found as expressed below:

NOTE: Not more than 2 corners, all in the same town and range, may be recorded on this certificate.

A. Description of original monument and accessories and/or subsequent restoration:

(K3) Corner common to Sections 1-2-11-12. 2002 - Recorded under the Iron County Remonumentation Program by Gary L. Pisoni PS in Liber 9 Page 326 of LCR. Found Wisconsin Michigan Power Company monument. Spruce 9" N50E 7.05', Spruce 8" N62W 16.94', Spruce 12" S26E 18.27', Spruce 4" S13W 25.93', Steel sign post S43W 0.76'.

(I5) Corner common to Sections 10-11-14-15. 1999 - Recorded under the Iron County Remonumentation Program by Gary L. Pisoni PS in Liber 8, Page 53 of LCR. Set 2" dia.x30" long aluminum pipe monument with 3 dia. aluminum cap. 8" B.Spruce, N07E 12.99', 4" R.Maple N88E 20.96', 7" B.Spruce S11W 16.58', 5/8" rebar SW 26.20', 5" B.Spruce S73W 24.83', Steel sign post North 0.68'.

B. Description of corner evidence found and/or method applied in restoring or reestablishing corner:

(K3) Found the monument of record, as described, in good condition, and at record bearing and distance from the 2002 witnesses, three of which are now standing dead. Left the monument in place and made new witnesses as described below.

(I5) Found the monument of record as described, in good condition, and at record bearing and distance from the 1999 witnesses, found as described. The witness B.Spruce S73W is dead and down. Left the monument in place and made one new witness as described below.


C. Description of monument for corner and accessories established to perpetuate locating the position of the corner:

(K3) Found 2" dia. Iron pipe with WMPCO cap.
 7" Spruce N50E 7.03' fd w/ old blazes
 Set measuring nail with MDNR tag in the side of:
 8" double Maple S60E 9.6' mrkd "S12 NBT"
 15" W.Spruce S23W 51.0' "S11 NBT"
 3" B.Spruce N11W 16.2' "S2 NBT"
 Steel sign post S54W 0.76'
 Bearings are magnetic.

(I5) Found 2" dia. pipe with 3" alum. Iron Co cap.
 All 1999 witnesses are in place but the
 B.Spruce S73W, dead and down.
 Set measuring nail with MDNR tag in the side of:
 5" Maple in clump N83W 26.0' mrkd "S10 NBT"
 Bearing is magnetic.

Signed by *Stephan J. Szyszkoski*
 Surveyor's Michigan License No. 33986

Date 02/18/2010

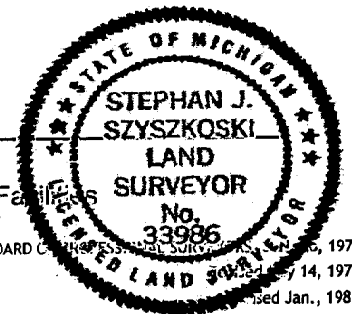

For the Michigan Department of Natural Resources and Environment, Office of Land and Forests

16372
 16375