

LAND CORNER RECORDATION CERTIFICATE
Filing Requirement of Act 74, Mich. P.A. 1970

For corners in
Iron


(County)	Located In:	Corner Code #/f
1. Public Land Survey	T 43N R 32W	D7
	T --- R ---	-----
	T --- R ---	-----
	T --- R ---	-----
2. Property Controlling in Section	S --- T --- R ---	-----
	S --- T --- R ---	-----
3. Miscellaneous Property in Sec.	S --- T --- R ---	-----
	S --- T --- R ---	-----

Register of Deeds Stamp & File Number

4 Lot No. _____, Recorded Plat _____
5 Private Claims _____

I, Stephan J. Szyszkowski, in a field survey on June 08, 1994, 19____ do hereby certify that under requirements of P.A. 74, Michigan P.A. of 1970, the corner points mentioned in lines 1 and 2 above were in conformance with regulations and rules therefore as required in the current manual of survey instructions of the United States Department of the Interior, Bureau of Land Management or by a decree of a Court of Law and/or that the corner points mentioned in lines 3, 4 and 5 above were in conformance with the rules of the Michigan Board of Land Surveyors or by a Decree of a Court of Law; established, re-established, monumented, re-monumented, recovered, found as expressed below.

NOTE: Not more than 4 corners, all in the same town and range, may be recorded on this certificate.

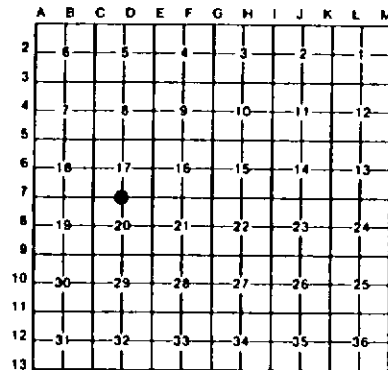

A. Description of original monument and accessories and/or subsequent restoration.

(D7) Quarter corner common to Sections 17-20. Corner established by Z.B. Searles, 1849 as follows: Set cedar post, Fir 10 S65E 18, Spruce 8 N70W 8. Original notes show the following along the true line (west) (1) 37.50 Descend ledge C. NE, (2) 40.00 Set Cedar Cr. Section post, (3) 44.21 W. Pine 12, (4) 62.28 Descend ledge 60 C.SSE, ... (5) 80.00 Section corner. Found no subsequent record.

B. Description of corner evidence found and/or method applied in restoring or reestablishing corner:

(D7) Recovered a 3/4" iron pipe at the corner position, with a wood post adjacent and faced by a 12" cedar with an old blaze. Verified the position of the pipe with reference to the original record noted above: (1) found ledge as described at record distance east; (2) original post and accessories not recovered; (3) recovered burned W. Pine stump of proper size at record distance west, insufficient remains to identify markings; (4) found sheer ledge as described (490' west of the pipe; (5) recovered a 1" iron bar monument 2568.61' west (71 ft. shorter than record). Former owner of the SW1/4 of Section 17 John Giordana told me that this pipe was found in place by him when he acquired that parcel in 1962. I note that the pipe is also at the proportionate position with respect to the original record between the monumented SE corner of section 17 and the sheer ledge to the west. The substantial shortage to the section corner 17-18-19-20 is possibly due to the difficult terrain and river crossing west from the westerly ledge, and I accordingly place less weight upon the reliability of the original record of 40.00 chains to that corner from D7. Based on the above, I regard the position of the pipe as substantiated by the original record and accept it as the best available evidence of the position of the original corner. Replaced the pipe with a 1" I.D. x 32" iron pipe capped with a 4" dia. cast aluminum MDNR tablet, appropriately stamped. Placed the 3/4" pipe adjacent.

C. Description of monument for corner and accessories established to perpetuate locating the position of the corner:

(D7) Set 1" I.D. pipe with 4" MDNR cap.
Blazed and scribed the following new bearing trees:
12" Cedar N07E 9.0' 1/4S NBT
9" Cedar N77W 70.3' 1/4S NBT
14" Cedar S79E 63.3' 1/4S NBT
Nail with MDNR tag in E. face P/P "CPT
B490 SPPS 430", S06E 47.93'
S84E 51.38' Found 5/8" iron pin
Set 6" cedar post squared and scribed
with location poster affixed, adjacent.
S84E 51.38' are magnetic.



Stephan J. Szyszkowski Date 6-14-94

Surveyor's Michigan License No. 33986