

**SURVEY & REMONUMENTATION**

**JAN 13 1998**

**SECTION**

IRON COUNTY  
MICHIGAN  
RECEIVED FOR RECORD

97 DEC 23 PM 1:29  
L.C. Records L.7 P. 153

**LAND CORNER RECORDATION CERTIFICATE**  
Filing Requirement of Act 74, Mich. P.A. 1970

*Gilbert Stiles*  
REGISTER OF DEEDS

For corners in


|                                    |                           |               |
|------------------------------------|---------------------------|---------------|
| <u>Iron</u><br>(County)            | Located In:               | Corner Code # |
| 1. Public Land Survey              | T <u>43N</u> R <u>33W</u> | <u>C-10</u>   |
|                                    | T _____ R _____           | _____         |
|                                    | T _____ R _____           | _____         |
|                                    | T _____ R _____           | _____         |
| 2. Property Controlling in Section | S _____ T _____ R _____   | _____         |
|                                    | S _____ T _____ R _____   | _____         |
| 3. Miscellaneous Property in Sec.  | S _____ T _____ R _____   | _____         |
|                                    | S _____ T _____ R _____   | _____         |

Register of Deeds Stamp & File Number

4. Lot No. \_\_\_\_\_, Recorded Plat \_\_\_\_\_  
5. Private Claims \_\_\_\_\_

Quarter Corner Sections 29 and 30, T43N, R33W

I, Gary L. Pisoni, in a field survey on November 25, 1997 do hereby state that under requirements of P.A. 74, Michigan P.A. of 1970, the corner points mentioned in lines 1 and 2 above were in conformance with regulations and rules therefore as required in the current manual of survey instructions of the United States Department of the Interior, Bureau of Land Management or by a decree of a Court of Law and/or that the corner points mentioned in lines 3, 4 and 5 above were in conformance with the rules of the Michigan Board of Land Surveyors or by a Decree of a Court of Law; established, re-established, monumented, recovered, found as expressed below:

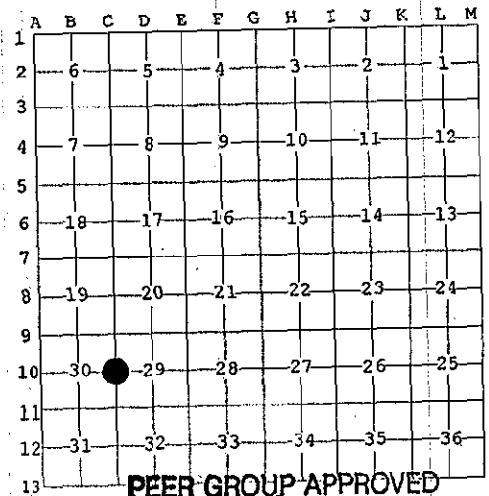

**PEER GROUP APPROVED**  
*Gary L. Pisoni 12-1-97*  
IRON COUNTY REPRESENTATIVE

**NOTE:** Not more than 2 corners, all in the same town and range, may be recorded on this certificate.

A. Description of original monument and accessories and/or subsequent restoration:

Original corner established in 1851 by Guy H. Carleton, U.S. Deputy Surveyor.  
Original Corner; Wood Post  
Original Bearing Trees: Sugar 10" N35° W 44 lks. (29.04 feet)  
Sugar 9" S50° E 19 lks. (12.54 feet)

On 3-2-1990, Brian R. Taavola, RLS with the Michigan Dept. Of Transportation, found a 1" squared iron pin which is being used as the quarter corner. This pin is described in Herb F. Larson's survey map dated February 1967. Taavola didn't replace pin. Recorded in Land Corner Certificate L.6, Page 219 on March 23, 1990.

1990 Bearing Trees:  
White Pine 8" N35° W 41.79 feet  
White Pine 8" N50° E 39.50 feet  
Power Pole #74-2481 S45° E 42.05 feet  
White Pine 10" S05° E 89.55 feet

B. Description of corner evidence found and/or method applied in restoring or reestablishing corner:

No original corner evidence was recovered.  
Found 1" squared iron pin as described above, iron pin is too far out of position to be acceptable, said pin is 52.05 feet from the correct position for the quarter corner. Found bearing trees as described above.

I restored the corner position by single proportionate measurement and on line between the Northwest and Southwest Section Corners of Section 29. Corner located along the middle of a large overhead utility transmission line.

Corner record research on file with County Representative.

C. Description of monument for corner and accessories established to perpetuate locating the position of the corner

At the proportionate position, set a 2 inch diameter aluminum pipe monument, 30 inches long, 1 inch above the ground surface, with a 3 inch diameter aluminum cap stamped as follows; Iron County Remonumentation, T43N, R33W, 1/4, S29, S30, 1997, RLS 27457. Blazed and scribed the following new bearing trees; (Measurements are taken to a nail in side of tree)

|                             |                |             |
|-----------------------------|----------------|-------------|
| White Pine 8"               | N43° E         | 47.45 feet  |
| White Spruce 12"            | S50° E         | 120.19 feet |
| Utility Pole #WMPCO-74-2481 | S43° W         | 27.18 feet  |
| Iron Bar 1"                 | N82° 42' 52" W | 52.05 feet  |
| Steel Sign Post             | South          | 0.60 feet   |



97-48  
Signed by Gary L. Pisoni Date November 29, 1997

Surveyor's Michigan License No. 27457