

SURVEY & REMONUMENTATION

APR 27 1995

LAND CORNER RECORDATION CERTIFICATE Filing Requirement of Act 74, Mich. P.A. 1970

IRON COUNTY
MICHIGAN
RECEIVED FOR RECORD

For corners in **COMMISSION**

95 FEB 10 PM 3: 27
L.C. RECORDS L.G. P. 352
Gilbert L. Letic
REGISTER OF DEEDS

IRON <small>(County)</small>	Located In:	Corner Code #
1. Public Land Survey	T 43N R 33W	<u>F-13</u>
	T _____ R _____	
	T 42N R 33W	F-1
	T _____ R _____	
2. Property Controlling in Section	S _____ T _____ R _____	
	S _____ T _____ R _____	
3. Miscellaneous Property in Sec.	S _____ T _____ R _____	
	S _____ T _____ R _____	

Register of Deeds Stamp & File Number

4. Lot No. _____, Recorded Plat _____
5. Private Claims _____

I, Alan K. Pierce, in a field survey on December, 19 94, do hereby certify that under requirements of P.A. 74, Michigan P.A. of 1970, the corner points mentioned in lines 1 and 2 above were in conformance with regulations and rules therefore as required in the current manual of survey instructions of the United States Department of the Interior, Bureau of Land Management or by a decree of a Court of Law and/or that the corner points mentioned in lines 3, 4 and 5 above were in conformance with the rules of the Michigan Board of Land Surveyors or by a Decree of a Court of Law; established, re-established, monumented, re-monumented, recovered, found as expressed below:

	A	B	C	D	E	F	G	H	I	J	K	L	M
2	6	5			4		3			2			1
3													
4	7	8			9		10			11			12
5													
6	18	17			16		15			14			13
7													
8	19	20			21		22			23			24
9													
10	30	29			28		27			26			25
11													
12	31	32			33		34			35			36
13													

NOTE: Not more than 4 corners, all in the same town and range, may be recorded on this certificate.

A. Description of original monument and accessories and/or subsequent restoration:

- F-1/13: Quarter corner to Sections 4 and 33, T42/43N-R33W.
- 1846: Austin Burt set a Spruce post during establishment of the Township line T42/43N and established the following witnesses: 10" Tamarack N12-1/2°E 29L; 8" Tamarack N63°W 45L.
- 1981: Plat of survey by R.L.S. No. 12585 recorded in Liber 1 S.M., Page 63 shows a found squared wood post with no witnesses. Corner was not recorded and no witnesses were noted.

B. Description of corner evidence found and/or method applied in restoring or reestablishing corner:

F-1/13; 1994, E C I: No original evidence recovered. Recovery of 1981 wood post uncertain. Found a 5/8" x 24" rebar with unreadable registration cap alongside a 4" square 5' high Spruce post witnessed by: 12" Cedar N70°E 24.6'; 8" Twin Tamarack N86°W 17.9'; 6" Red Maple N09°W 9.9'. The following measurements were taken to G.L.O. terrain calls: "Top of hill - W" 825' G.L.O. - 819' E C I (irregular margin); "Leave swamp and ascend hill - W" 330' G.L.O. - 350' E C I (meandering edge); "Enter open Tamarack swamp - E" 132' G.L.O. - 114' E C I; 50 link stream - E" 1584' G.L.O. - 1604' E C I (stream is wider now). Corner position established by acceptance of found 5/8" capped rebar as a careful and faithful perpetuation of the position of the original corner. Set Iron County Remonumentation monument, a 3/4" diameter x 7' long aluminum rod with a 3" diameter aluminum cap stamped to identify corner, about 0.2' above grade and establishes witnesses. Found rebar was left lying along side the monument. Distance West to E-1/13 2640.57'; distance East to W.C.M.C. 1442.78'.

PEER GROUP APPROVED
Iron County Representative
COUNTY REPRESENTATIVE
AP 1-25-95

C. Description of monument for corner and accessories established to perpetuate locating the position of the corner:


Bearing trees are face, nail, and butt blazed and painted yellow. Distances are measured from a 16d double head nail with an orange plastic washer stamped "E C I - 30097" in the side of the bearing tree. Face blaze is scribed with an "X". Butt blaze is scribed "BT". Metal sign/tag placed above face blaze.

F-1/13 Set Iron County Remonumentation monument witnessed by:

7" Tamarack N46°E 8.36'
10" Tamarack S13°W 8.94'

10" Tamarack S42°E 19.43'
7" Tamarack N90°W 18.15'

Sign Post N00°E 1.00'

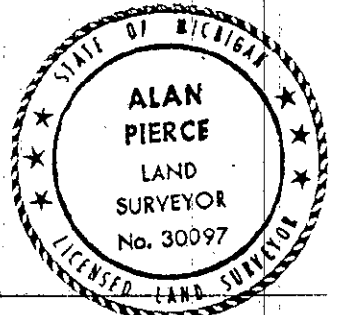

Signed by *Alan K. Pierce*
Surveyor's Michigan License No. 30097

Date 1-12-95