

**SURVEY &
REMONUMENTATION**

JAN 19 1999

SECTION

**LAND CORNER RECORDATION CERTIFICATE
Filing Requirement of Act 74, Mich. P.A. 1970**

For corners in

<u>Iron</u> (County)	Located In:	Corner Code #
1. Public Land Survey	T <u>43N</u> R <u>33W</u>	<u>G-9</u>
	T _____ R _____	_____
	T _____ R _____	_____
	T _____ R _____	_____
2. Property Controlling in Section	S _____ T _____ R _____	_____
	S _____ T _____ R _____	_____
3. Miscellaneous Property in Sec.	S _____ T _____ R _____	_____
	S _____ T _____ R _____	_____

IRON COUNTY
MICHIGAN
RECEIVED FOR RECORD
98 DEC 29 AM 11:22
L.C. Records 1.7, P. 300
Richard Stelice
Register of Deeds Stamp & File Number

4. Lot No. _____, Recorded Plat _____
5. Private Claims _____

Section Corner Sections 21, 22, 27 and 28, T43N, R33W

I, Gary L. Pisoni, in a field survey on Nov. 25, 1998 do hereby state that under requirements of P.A. 74, Michigan P.A. of 1970, the corner points mentioned in lines 1 and 2 above were in conformance with regulations and rules therefore as required in the current manual of survey instructions of the United States Department of the Interior, Bureau of Land Management or by a decree of a Court of Law and/or that the corner points mentioned in lines 3, 4 and 5 above were in conformance with the rules of the Michigan Board of Land Surveyors or by a Decree of a Court of Law; established, re-established, monumented, recovered, found as expressed below:

	A	B	C	D	E	F	G	H	I	J	K	L	M
1													
2		6		5		4		3		2		1	
3													
4		7		8		9		10		11		12	
5													
6		18		17		16		15		14		13	
7													
8		19		20		21		22		23		24	
9													
10		30		29		28		27		26		25	
11													
12		31		32		33		34		35		36	
13													

NOTE: Not more than 2 corners, all in the same town and range, may be recorded on this certificate.

A. Description of original monument and accessories and/or subsequent restoration:

Original corner established on September 14, 1851 by Guy H. Carleton, U.S. Deputy Surveyor.

Original Corner; Wood Post

Original Bearing Trees:

Yellow Birch	14"	N 65° W	31 links (20.46 feet)
Fir	10"	S 30° E	24 links (15.84 feet)

On 6/23/75, Arthur O. Enger, RLS with Michigan Dept. of Natural Resources restored the corner position from a found iron bar. Iron bar dates at least to the early 1940's as shown on a M.D.O.T. Highway Plan maps. Corner aligns with edge of old farm field to the West. He replaced iron bar with a 1" x 24" iron pipe with a 3 1/2" aluminum cap buried 4" below road bed surface, recorded in L.C. Certificate, Liber 1, Pages 505 on 8/18/77.

1975 Bearing Trees:

Sugar Maple	12"	S 50° E	37.9 feet
Sugar Maple	6"	S 39 1/2° W	29.5 feet

B. Description of corner evidence found and/or method applied in restoring or reestablishing corner:

No evidence of original B.T.s found. Found monument as described above and the following bearing trees:

Sugar Maple	14"	S 46° E	38.32 feet
Sugar Maple	12"	S 42° W	29.59 feet

I accept the monument as the best available evidence for restoring the corner position.

Corner record research on file with County Representative.

PEER GROUP APPROVED
Ken A. Pisoni 12-18-98
COUNTY REPRESENTATIVE

C. Description of monument for corner and accessories established to perpetuate locating the position of the corner:

Blazed and scribed the following new bearing trees: (All measurements taken to a nail in side of tree)


Sugar Maple	6"	N 77° E	41.38 feet
Balsam	4"	N 22° W	46.76 feet
Steel sign post		S 89° W	15.25 feet

98-148

Signed by Gary L. Pisoni Date 12-21-98

Surveyor's Michigan License No. 27457

FORM APPROVED BY MICHIGAN STATE BOARD OF PROFESSIONAL SURVEYORS, JAN. 28, 1971
REVISED MAY 14, 1975
REVISED JAN., 1983
REVISED OCT., 1995

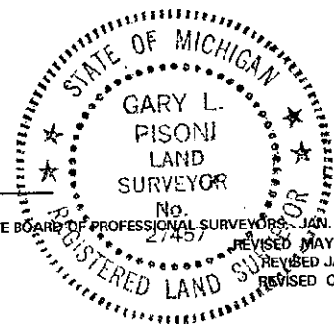

1.7 P. 300