

**SURVEY & REMONUMENTATION**

JAN 19 1999

**SECTION**

**LAND CORNER RECORDATION CERTIFICATE**  
Filing Requirement of Act 74, Mich. P.A. 1970

For corners in

_____ Iron _____ (County)	Located In:	Corner Code #
1. Public Land Survey	T <u>43N</u> R <u>33W</u>	<u>1-12</u>
	T _____ R _____	_____
	T _____ R _____	_____
	T _____ R _____	_____
2. Property Controlling in Section	S _____ T _____ R _____	_____
	S _____ T _____ R _____	_____
3. Miscellaneous Property in Sec.	S _____ T _____ R _____	_____
	S _____ T _____ R _____	_____

IRON COUNTY MICHIGAN  
RECEIVED FOR RECORD

98 DEC 28 AM 11:18  
L.C. Record: L. 7, P. 279

*Gary L. Pisoni*  
1998

Register of Deeds Stamp & File Number

4. Lot No. \_\_\_\_\_, Recorded Plat \_\_\_\_\_  
5. Private Claims \_\_\_\_\_

Quarter Corner Sections 34, and 35, T43N, R33W

I, Gary L. Pisoni, in a field survey on Nov. 12, 1998 do hereby state that under requirements of P.A. 74, Michigan P.A. of 1970, the corner points mentioned in lines 1 and 2 above were in conformance with regulations and rules therefore as required in the current manual of survey instructions of the United States Department of the Interior, Bureau of Land Management or by a decree of a Court of Law and/or that the corner points mentioned in lines 3, 4 and 5 above were in conformance with the rules of the Michigan Board of Land Surveyors or by a Decree of a Court of Law; established, re-established, monumented, recovered, found as expressed below:

	A	B	C	D	E	F	G	H	I	J	K	L	M
1													
2	6			5				4		3		2	1
3													
4	7			8				9		10		11	12
5													
6	18			17				16		15		14	13
7													
8	19			20				21		22		23	24
9													
10	30			29				28		27		26	25
11													
12	31			32				33		34		35	36
13													

NOTE: Not more than 2 corners, all in the same town and range, may be recorded on this certificate.

A. Description of original monument and accessories and/or subsequent restoration:

Original corner established in September, 1851 by Guy H. Carleton, Deputy Surveyor.  
Original Corner; Wood Post  
Original Bearing Trees:

Sugar	12"	N 35° W	22 lks (14.52 feet)
Sugar	14"	S 30° E	28 lks (18.48 feet)

In June 1985, Charles E. Hein, RLS, found a 1" by 3/4" iron bar in the centerline of a four way road intersection marking corner position.  
No bearing trees set. Plat of Survey is recorded in Plats of Certified Surveys, Liber 1, Page 137 on 11/20/90.

PEER GROUP APPROVED  
IRON A. L. 12-18-98  
COUNTY REPRESENTATIVE

B. Description of corner evidence found and/or method applied in restoring or reestablishing corner:

No evidence of original B.T.s found. Found a 1" x 3/4" iron bar as described above, 3" below road bed surface and located in the centerline of a four way road intersection.  
Also, found a 1" diameter iron pipe, 3" below road bed surface located in County Road, said pipe is N 33° 09'08"W, 5.34 feet from quarter corner position.

Distances along the Section line are consistent with GLO distances.

I accept the above iron bar as the best available evidence for restoring the corner position. Iron bar has been used for various surveys in Sections 34 and 35.

Corner record research on file with County Representative.

C. Description of monument for corner and accessories established to perpetuate locating the position of the corner:  
From the above described corner position, I set two reference monuments, being 5/8" diameter by 30" long rebar, with a 3" aluminum cap stamped as follows: Iron County Remonumentation, T43N, R33W, R.M., 1/4, S-34, S-35, N 55° E, 46.89', 1998, RLS 27457; T43N, R33W, R.M., 1/4, S-34, S-35, S 73° E, 90.92', 1998, RLS 27457 from which I blazed and scribed the following new bearing trees: (All measurements taken to a nail in side of tree)

Utility Pole #22/29		N 42° E	44.70 feet
Red Pine	11"	S 56° E	57.21 feet
R.M.	5/8" x 30" rebar	S 55° W	46.89 feet
R.M.	5/8" x 30" rebar	N 73° W	90.92 feet
Steel sign post		S 55° W	47.57 feet
Top of hydrant		N 48° W	77.83 feet
Iron Pipe	1" diameter	N 33° 09' 08" W	5.34 feet


98-109

Signed by Gary L. Pisoni

Date 12-21-98

Surveyor's Michigan License No. 27457

FORM APPROVED BY MICHIGAN STATE BOARD OF PROFESSIONAL SURVEYORS, JAN. 28, 1971  
REVISED MAY 14, 1975  
REVISED JAN., 1983  
REVISED OCT., 1995

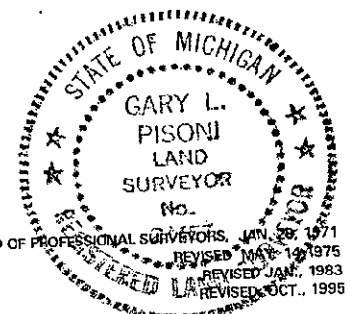

L. 7 P. 279