

SURVEY & REMONUMENTATION

APR 27 1995

LAND CORNER RECORDATION CERTIFICATE Filing Requirement of Act 74, Mich. P.A. 1970

For corners in **COMMISSION**

| | | | |
|--|---------------------------|---------------|--|
| <u>Iron</u> <small>(County)</small> | Located In: | Corner Code # | |
| 1. Public Land Survey | T <u>43N</u> R <u>33W</u> | <u>I-13</u> | |
| | T <u>42N</u> R <u>33W</u> | <u>I-1</u> | |
| | T _____ R _____ | | |
| | T _____ R _____ | | |
| 2. Property Controlling in Section | S _____ T _____ R _____ | | |
| | S _____ T _____ R _____ | | |
| 3. Miscellaneous Property in Sec. | S _____ T _____ R _____ | | |
| | S _____ T _____ R _____ | | |

REGISTRARS OFFICE) ..SS
IRON COUNTY, MICH.) ..SS
RECEIVED FOR RECORD THE 21ST DAY OF
FEBRUARY A.D. 19 95 AT
2:45 O'CLOCK P. M. AND RECORDED IN LIBER
6 OF LC RECORDS
ON PAGE 362
Mark J. Jones
DEPUTY REGISTER OF DEEDS

Register of Deeds Stamp & File Number

4. Lot No. _____, Recorded Plat _____
5. Private Claims _____

Section Corner 34, 35, 3, 2,
T43N R33W
T42N R33W

I, Gary L. Pisoni, in a field survey on September 1, 19 94, do hereby certify that under requirements of P.A. 74, Michigan P.A. of 1970, the corner points mentioned in lines 1 and 2 above were in conformance with regulations and rules therefore as required in the current manual of survey instructions of the United States Department of the Interior, Bureau of Land Management or by a decree of a Court of Law and/or that the corner points mentioned in lines 3, 4 and 5 above were in conformance with the rules of the Michigan Board of Land Surveyors or by a Decree of a Court of Law; established, re-established, monumented, re-monumented, recovered, found as expressed below:

| | A | B | C | D | E | F | G | H | I | J | K | L | M |
|----|----|---|----|---|----|---|----|---|----|---|----|---|---|
| 2 | 6 | | 5 | | 4 | | 3 | | 2 | | 1 | | |
| 3 | | | | | | | | | | | | | |
| 4 | 7 | | 8 | | 9 | | 10 | | 11 | | 12 | | |
| 5 | | | | | | | | | | | | | |
| 6 | 18 | | 17 | | 16 | | 15 | | 14 | | 13 | | |
| 7 | | | | | | | | | | | | | |
| 8 | 19 | | 20 | | 21 | | 22 | | 23 | | 24 | | |
| 9 | | | | | | | | | | | | | |
| 10 | 30 | | 29 | | 28 | | 27 | | 26 | | 25 | | |
| 11 | | | | | | | | | | | | | |
| 12 | 31 | | 32 | | 33 | | 34 | | 35 | | 36 | | |
| 13 | | | | | | | | | | | | | |

NOTE: Not more than 4 corners, all in the same town and range, may be recorded on this certificate.

A. Description of original monument and accessories and/or subsequent restoration:

Original corner established by Austin Burt, U.S. Deputy Surveyor in 1846.
Original corner: Sugar Post
Original bearing trees:

| | | | |
|-------|-----|---------|-----------------------|
| Sugar | 12" | N 46° E | 63 links (41.58 feet) |
| Sugar | 10" | N 13° W | 21 links (13.86 feet) |
| Sugar | 12" | S 30° W | 56 links (36.96 feet) |
| Sugar | 10" | S 50° E | 78 links (51.48 feet) |

B. Description of corner evidence found and/or method applied in restoring or reestablishing corner:

No evidence of original corner or bearing tree remains. Corner position found marked by a 1" dia. iron bar and located in the centerline of a North/South county road and located on a East/West wire and rock fence line. Corner position has been used and accepted as the corner locally for many years. Set an aluminum pipe monument over the top of iron bar as described below. Monument is 6" below road bed surface.

This corner is accepted as the best available evidence of the position of the original corner.

County Record Research on file with County Representative office.

PEER GROUP APPROVED

Iron Gary L. Pisoni
COUNTY REPRESENTATIVE


A.P. 11-03-94

C. Description of monument for corner and accessories established to perpetuate locating the position of the corner:

At the corner position, I set a 2" diameter by 30" long split base aluminum pipe monument with a 3" cast aluminum cap, stamped to read: Iron County Remonumentation, T43N, R33W, S-34, S-35, S-3, S-2, T42N, 1994, RLS- 27457 from which I established the following new blazed and scribed bearing trees: (all measurements taken to a nail in side of tree:

| | | | |
|----------------------|-----------|---------|------------|
| Existing Sugar Maple | 15" clump | S 53° E | 63.23 feet |
| " Red Pine | 16" | S 52° W | 46.62 feet |
| " Sugar Maple | 12" clump | S 87° W | 37.03 feet |
| Rebar | 5/8" | N 64° E | 37.50 feet |
| Steel Sign Post | | West | 23.82 feet |

Signed by *Gary L. Pisoni*
Surveyor's Michigan License No. 27457

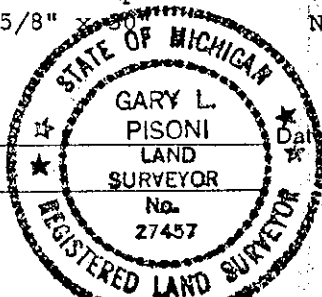

FORM APPROVED BY MICHIGAN STATE BOARD OF LAND SURVEYORS, JAN. 28, 1971
REVISED MAY 14, 1975
REVISED JAN., 1983

LIBER **6** PAGE **362**