

1993

COMMISSION

LAND CORNER RECORDATION CERTIFICATE
Filing Requirement of Act 74, Mich. P.A. 1970

IRON COUNTY MICHIGAN
RECEIVED FOR RECORD

93 DEC 29 PM 2: 21
L.C. RECORDS L.C. P. 299

Gilbert Stebbins
REGISTER OF DEEDS

For corners in


Iron (County)	Located In:	Corner Code #
1. Public Land Survey	T 43N R 33W	K-7
	T _____ R _____	_____
	T _____ R _____	_____
	T _____ R _____	_____
2. Property Controlling in Section	S _____ T _____ R _____	_____
	S _____ T _____ R _____	_____
3. Miscellaneous Property in Sec.	S _____ T _____ R _____	_____
	S _____ T _____ R _____	_____

Register of Deeds Stamp & File Number

- 4. Lot No. _____, Recorded Plat _____
- 5. Private Claims _____

Section Corner 14-13-23-24 T43N R33W

I, Gary L. Pisoni, in a field survey on December 20, 19 93, do hereby certify that under requirements of P.A. 74, Michigan P.A. of 1970, the corner points mentioned in lines 1 and 2 above were in conformance with regulations and rules therefore as required in the current manual of survey instructions of the United States Department of the Interior, Bureau of Land Management or by a decree of a Court of Law and/or that the corner points mentioned in lines 3, 4 and 5 above were in conformance with the rules of the Michigan Board of Land Surveyors or by a Decree of a Court of Law; established, re-established, monumented, re-monumented, recovered, found as expressed below:

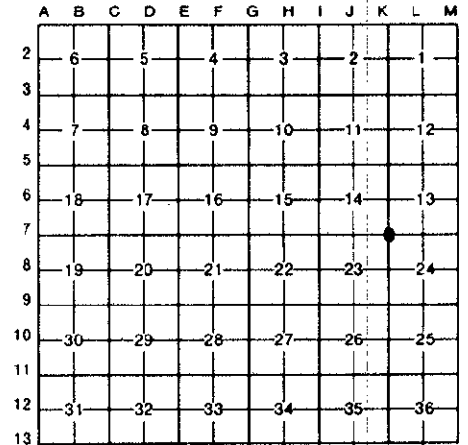

NOTE: Not more than 4 corners, all in the same town and range, may be recorded on this certificate.

A. Description of original monument and accessories and/or subsequent restoration:

Original corner established by Guy H. Carleton, U.S. Deputy Surveyor in 1851.
 Original corner: Wood Post
 Original bearing trees:

Maple	12"	N 65° E	22 links (14.52 feet)
Hemlock	16"	S 40° W	25 links (16.50 feet)

B. Description of corner evidence found and/or method applied in restoring or reestablishing corner:

No evidence of original corner or bearing tree remains. Corner position found marked by a 36" narrow gauged railroad rail. Corner position has been used and accepted locally, for many years. Layed railroad rail next to monument as described below. Monument is 2" above ground surface.


This corner is accepted as the best available evidence of the position of the original corner.

Corner was recovered by Arthur O. Enger RLS, M.D.N.R. on December 21, 1976 as recorded in Liber 1, page 510 of Land Recordation Certificates.

C. Description of monument for corner and accessories established to perpetuate locating the position of the corner:

At the corner position, I set a 2" diameter by 30" long split base aluminum pipe monument with a 3" cast aluminum cap, stamped to read: Iron County Remonumentation, T43N, R33W, S-14, S-13, S-23, S-24, 1993, RLS-27457 from which I established the following new blazed and scribed bearing trees: (all measurements taken to a nail in side of tree)

Red Pine (existing)	25"	N 56° E	80.22 feet
Red Pine (new)	11"	S 88° E	46.96 feet
Utility Pole #74-2656		S 13° W	114.56 feet
Utility Pole #76-0952		N 69° W	36.72 feet
Steel Sign Post		North	1.37 feet

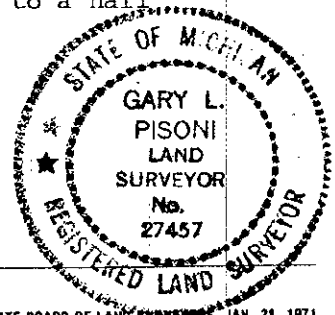

Signed by Gary L. Pisoni Date 12-28-93

Surveyor's Michigan License No. 27457