

**SURVEY &  
REMONUMENTATION**

JAN 19 1999

**SECTION**

**LAND CORNER RECORDATION CERTIFICATE  
Filing Requirement of Act 74, Mich. P.A. 1970**

For corners in

Iron (County)	Located In:	Corner Code #
1. Public Land Survey	T <u>43N</u> R <u>33W</u>	<u>K-10</u>
	T _____ R _____	_____
	T _____ R _____	_____
	T _____ R _____	_____
2. Property Controlling in Section	S _____ T _____ R _____	_____
	S _____ T _____ R _____	_____
3. Miscellaneous Property in Sec.	S _____ T _____ R _____	_____
	S _____ T _____ R _____	_____

IRON COUNTY  
MICHIGAN  
RECEIVED FOR RECORD

98 DEC 28 AM 11:24  
L.C. Records: L.7, P. 313

*Gary L. Pisoni*  
REGISTERED LAND SURVEYOR

Register of Deeds Stamp & File Number

4. Lot No. \_\_\_\_\_, Recorded Plat \_\_\_\_\_  
5. Private Claims \_\_\_\_\_

Quarter Corner Sec. 25 and 26, T43N, R33W

I, Gary L. Pisoni, in a field survey on Dec. 14, 1998 do hereby state that under requirements of P.A. 74, Michigan P.A. of 1970, the corner points mentioned in lines 1 and 2 above were in conformance with regulations and rules therefore as required in the current manual of survey instructions of the United States Department of the Interior, Bureau of Land Management or by a decree of a Court of Law and/or that the corner points mentioned in lines 3, 4 and 5 above were in conformance with the rules of the Michigan Board of Land Surveyors or by a Decree of a Court of Law; established, re-established, monumented, recovered, found as expressed below:

	A	B	C	D	E	F	G	H	I	J	K	L	M
1													
2	6			5		4		3			2		1
3													
4	7			8		9		10		11		12	
5													
6	18			17		16		15		14		13	
7													
8	19			20		21		22		23		24	
9													
10	30			29		28		27		26		25	
11													
12	31			32		33		34		35		36	
13													

**NOTE:** Not more than 2 corners, all in the same town and range, may be recorded on this certificate.

**A. Description of original monument and accessories and/or subsequent restoration:**

Original corner established in September 1851 by Guy H. Carleton, U.S. Deputy Surveyor.  
Original Corner; Wood Post  
Original Bearing Trees:

Fir	10"	N 45°E	32 lks (21.12 feet)
Sugar	14"	S 50°W	35 lks (23.10 feet)

PEER GROUP APPROVED  
*Gary L. Pisoni 12-18-98*  
COUNTY REPRESENTATIVE

**B. Description of corner evidence found and/or method applied in restoring or reestablishing corner:**

No evidence of original B.T.s found. Corner restored midway between the Northeast and Southeast Section corners of Section 26 and located on line from the Southerly extension of a wire fence line, from the North. Corner falls in a ditch line along North side of U.S. Highway No. 2.

Distance along the Section line is consistent with GLO distance.

Corner record research on file with County Representative.


**C. Description of monument for corner and accessories established to perpetuate locating the position of the corner:**

At the corner position, set a 2" diameter by 30" long split base aluminum pipe monument with a 3" diameter aluminum cap stamped as follows: Iron County Remonumentation, T43N, R33W, 1/4, S-26, S-25, 1998, RLS 27457 from which I established the following new blazed and scribed bearing tree: (All measurements taken to a nail in side of tree)

Red Pine	27"	N 47° W	36.52 feet
Red Maple	7"	N 21°E	36.38 feet
Balsam	8"	N 76°E	65.80 feet
Steel sign post		North	9.53 feet

98-101  
Signed by *Gary L. Pisoni* Date 12-21-98  
Surveyor's Michigan License No. 27457

FORM APPROVED BY MICHIGAN STATE BOARD OF PROFESSIONAL SURVEYORS, JAN. 8, 1971  
REVISED MAY 14, 1975  
REVISED JAN., 1983  
REVISED OCT., 1995

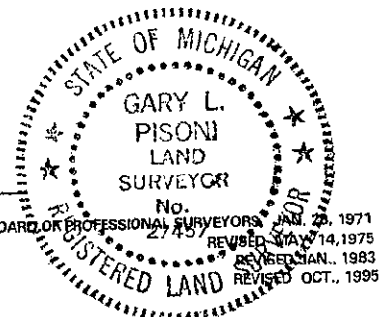

L.7 P. 313