

SURVEY & RECONSTRUCTION

FEB 22 1996

COMMISSION

LAND CORNER RECORDATION CERTIFICATE  
Filing Requirement of Act 74, Mich. P.A. 1970

For corners in

Iron (County) Located In: Corner Code #


1. Public Land Survey	T 44N R 32W	A-13
	T 43N R 32W	A-13
	T 44N R 33W	M-13
	T 43N R 33W	M-13
2. Property Controlling in Section	S T R	
3. Miscellaneous Property in Sec.	S T R	

REGISTERS OFFICE )  
IRON COUNTY, MICH. ) ..SS  
RECEIVED FOR RECORD THE 21<sup>ST</sup> DAY OF  
FEBRUARY A.D. 19 95 AT  
2:45 O'CLOCK P.M. AND RECORDED IN LIBER  
6 OF L.C. RECORDS  
ON PAGE 363  
DEPUTY REGISTER OF DEEDS  
Register of Deeds Stamp & File Number

4. Lot No. \_\_\_\_\_, Recorded Plat \_\_\_\_\_  
5. Private Claims \_\_\_\_\_

Section Corner 36, 31, 1, 6, T44N R33W, R32W  
T43N

I, Gary L. Pisoni, in a field survey on September 6, 1994 do hereby certify that under requirements of P.A. 74, Michigan P.A. of 1970, the corner points mentioned in lines 1 and 2 above were in conformance with regulations and rules therefore as required in the current manual of survey instructions of the United States Department of the Interior, Bureau of Land Management or by a decree of a Court of Law and/or that the corner points mentioned in lines 3, 4 and 5 above were in conformance with the rules of the Michigan Board of Land Surveyors or by a Decree of a Court of Law; established, re-established, monumented, re-monumented, recovered, found as expressed below:

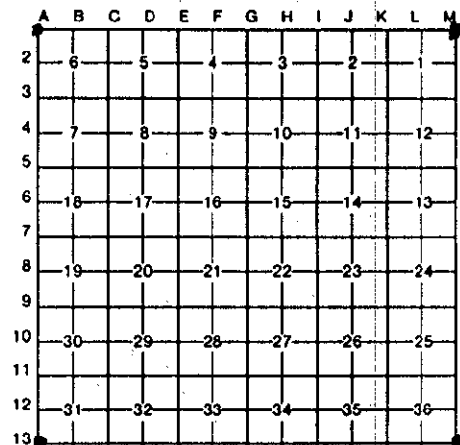

NOTE: Not more than 4 corners, all in the same town and range, may be recorded on this certificate.

A. Description of original monument and accessories and/or subsequent restoration:

Original corner established by Austin Burt, U.S Deputy Surveyor in 1846.

Original corner: Sugar Post

Original bearing trees:

Lynn	12"	S 37°E	18 links (11.88 feet)
Sugar	12"	N 10°W	30 links (19.80 feet)

B. Description of corner evidence found and/or method applied in restoring or reestablishing corner:

No evidence of original corner or bearing tree remains. Corner position found marked by a 1" x 3' long drill rod and located in a gravel road. Drill rod is 2' East of county road centerline running North and 5' North of existing centerline of a county road running East and West. Corner position has been used and accepted as the corner locally for many years. Corner position checks within reason to GLO distance East/West/North/South. Set an aluminum pipe monument over the top of drill rod as described below. Monument is 6" below road bed surface.

This corner is accepted as the best available evidence of the position of the original corner.

County Record Research on file with County Representative office.


PEER GROUP APPROVED

GARY L. PISONI  
COUNTY REPRESENTATIVE

C. Description of monument for corner and accessories established to perpetuate locating the position of the corner: A.P. 11-03-94

At the corner position, I set a 2" diameter by 30" long split base aluminum pipe monument with a 3" cast aluminum cap, stamped to read: Iron County Remonumentation, T44N, R33W, R32W, S-36, S-31, S-1, S-6, T43N, 1994, RLS- 27457 from which I established the following new blazed and scribed bearing trees: (all measurements taken to a nail in side of tree)

Rebar	5/8" x 30"	N 52°E	43.07 feet
Sugar Maple	16"	S 55°E	44.81 feet
Hemlock	8"	S 57°W	51.11 feet
Sugar Maple	12"	N 45°W	45.03 feet
Steel Sign Post		South	23.83 feet

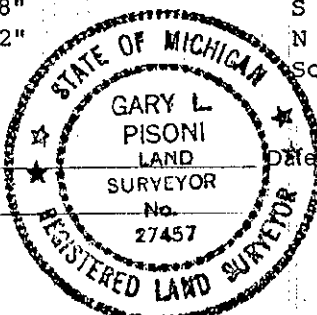

Signed by Gary L. Pisoni  
Surveyor's Michigan License No. 27457