COUNTY &
LAND ...

FEB 2 2 1996

LAND CORNER RECORDATION CERTIFICATE

Filing Requirement of Act 74, Mich. P.A. 1970

IRON COUNTY
MICHIGAN
RECEIVED FOR RECORD

95 JAN 17 AM 8:42
L.C. RECORDS L.6 P. 327
Eileen Stebic
REGISTER OF DEEDS

Register of Deeds Stamp & File Number

For corners in Iron (County)

	Located In:	Corner Code #
1. Public Land Survey Section 7	T 43N R 32W	A-4
	T 43N R 33W	M-4
	T ___ R ___	
	T ___ R ___	
2. Property Controlling	S ___ T ___ R ___	
in Section	S ___ T ___ R ___	
3. Miscellaneous	S ___ T ___ R ___	
Property in Sec.	S ___ T ___ R ___	

4. Lot No. _____, Recorded Plat _____
5. Private Claims _____

West 1/4 Section 7

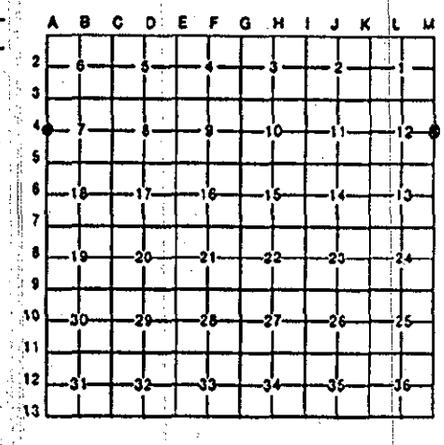

I, John R. Garske, in a field survey on November 1, 1994, do hereby certify that under requirements of P.A. 74, Michigan P.A. of 1970, the corner points mentioned in lines 1 and 2 above were in conformance with regulations and rules therefore as required in the current manual of survey instructions of the United States Department of the Interior, Bureau of Land Management or by a decree of a Court of Law and/or that the corner points mentioned in lines 3, 4 and 5 above were in conformance with the rules of the Michigan Board of Land Surveyors or by a Decree of a Court of Law; established, re-established, monumented, re-monumented, recovered, found as expressed below:

NOTE: **Not more than 4 corners, all in the same town and range, may be recorded on this certificate.**

A. Description of original monument and accessories and/or subsequent restoration:

1846 - Township Boundary by Austin Burt. Original bearing trees: W. pine 14" - S45°E, 9; Y. pine 20" - N34°W, 32.

1969 - MDOT construction plans show a found 3/4" re-rod, witnesses to corner position: 18" pine - S40°E, 34.93 feet; 18" pine - N40°E, 36.05 feet; 20" pine - N05°E, 43.43 feet.

B. Description of corner evidence found and/or method applied in restoring or reestablishing corner:

I found a 3/4" steel pin in the monument box below the south gravel shoulder of Paint River Road, 118.7 (118.5 MDOT) feet east of U.S. 141. The corner checks with the 1969 MDOT plans as the corner they found. Accepted pin as corner position after making distance checks north and south to known corners.
County Record Reserch and field search forms on file with the County Representative. See sketch in L.6 P.325 of Land Corner Records.

PEER GROUP APPROVED
Ron Gary L. Pure
COUNTY REPRESENTATIVE
A.P. 12-15-94

C. Description of monument for corner and accessories established to perpetuate locating the position of the corner:

Raised the 3/4" pin with a 30" x 5/8" rebar with a stamped 2" aluminum cap set in the monument box. Established the following references: found Power Pole #N69-526 - N39°E, 53.67 feet; found 16" red pine - S84°E, 109.72 feet; found 27" red pine - S15°E, 103.59 feet; chiseled "X" top of curb 1 foot west of east end - N67°W, 60.81 feet.

STATE OF MICHIGAN
JOHN R. GARSKE
LAND SURVEYOR
No. 28410
LICENSED SURVEYOR

Signed by John R Garske Date 12/1/94
Surveyor's Michigan License No. 28410

FORM APPROVED BY MICHIGAN STATE BOARD OF LAND SURVEYORS, JAN. 28, 1971
REVISED MAY 14, 1975
REVISED JAN., 1983

LIBER 6 PAGE 327 A-4