

FEB 22 1996

LAND CORNER RECORDATION CERTIFICATE
Filing Requirement of Act 74, Mich. P.A. 1970

IRON COUNTY
MICHIGAN
RECEIVED FOR RECORD

95 JAN 17 AM 8:42

L.C. RECORDS L.6 P. 329

Edwin Stiles
REGISTER OF DEEDS

Register of Deeds Stamp & File Number

For corners in Iron Located In: _____ Corner Code A-6
(County)

1. Public Land Survey Section 18 T 43N R 32W
T 43N R 33W
T _____ R _____
T _____ R _____

2. Property Controlling S _____ T _____ R _____
in Section S _____ T _____ R _____

3. Miscellaneous S _____ T _____ R _____
Property in Sec. S _____ T _____ R _____

4. Lot No. _____, Recorded Plat _____
5. Private Claims _____
West 1/4 Section 18

I, John R. Garske, in a field survey on November 1, 1994, do hereby certify that under requirements of P.A. 74, Michigan P.A. of 1970, the corner points mentioned in lines 1 and 2 above were in conformance with regulations and rules therefore as required in the current manual of survey instructions of the United States Department of the Interior, Bureau of Land Management or by a decree of a Court of Law and/or that the corner points mentioned in lines 3, 4 and 5 above were in conformance with the rules of the Michigan Board of Land Surveyors or by a Decree of a Court of Law; established, re-established, monumented, re-monumented, recovered, found as expressed below:

NOTE: Not more than 4 corners, all in the same town and range, may be recorded on this certificate.

	A	B	C	D	E	F	G	H	I	J	K	L	M
2	8	5	4	3	2	1							
3													
4	7	8	9	10	11	12							
5													
6	16	17	16	15	14	13							
7													
8	19	20	21	22	23	24							
9													
10	30	29	28	27	26	25							
11													
12	31	32	33	34	35	36							
13													

A. Description of original monument and accessories and/or subsequent restoration:

1846 - Township Boundary by Austin Burt, D.S. Original bearing trees: Y. pine 16" - S59°W, 9; Do 14" - N49°E, 15.

1969 - MDOT construction plans, witnesses to corner position: found 1" iron pipe; 14" pine - N25°E, 6.71; 5" birch - N50°W, 13.83 feet; 4" poplar - S15°E, 9.89 feet.

B. Description of corner evidence found and/or method applied in restoring or reestablishing corner:


I found a 1" water pipe next to a fallen cedar fence post as noted on the 1969 MDOT plans. I also found their pine and birch bearing trees to confirm the pipe as the pipe they used. Private surveys have used this pipe as the one-quarter corner for many years as shown on 1988 survey by Gary Pisoni, RLS. I am accepting this corner because of its history of past use and acceptance.

County Record Reserch and field search forms on file with the County Representative. See sketch in L.6 P.325 of Land Corner Records.

PEER GROUP APPROVED
Iron County Rep. Group
COUNTY REPRESENTATIVE
A.P. 12-15-94

C. Description of monument for corner and accessories established to perpetuate locating the position of the corner:

Set standard Iron Co. monument, 2 1/2" pipe x 30" long pipe with a 3 1/4" diameter aluminum cap stamped and established the following references: 13" twin red pine - N25°E, 6.58 feet; 11" red pine - S67°E, 46.49 feet; 6" red maple in clump - S21°E, 54.66 feet; 5" red pine - N55°W, 55.75 feet; SSP - west, 1.59 feet.

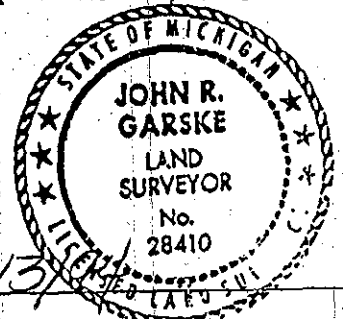

Signed by John R. Garske Date 12/13/94
Surveyor's Michigan License No. 28410

FORM APPROVED BY MICHIGAN STATE BOARD OF LAND SURVEYORS, JAN. 28, 1971
REVISED MAY 14, 1975
REVISED JAN., 1983