

FEB 28 1996

COMMISSION

LAND CORNER RECORDATION CERTIFICATE
Filing Requirement of Act 74, Mich. P.A. 1970

For corners in

Iron (County)

Located In:

Corner Code #

1. Public Land Survey

T 43N R 32W

A-9

T 43N R 33W

M-9

T R

T R

2. Property Controlling in Section

S T R

S T R

3. Miscellaneous Property in Sec.

S T R

S T R

REGISTERS OFFICE IRON COUNTY, MICH. SS

RECEIVED FOR RECORD THE 21ST DAY OF FEBRUARY A.D. 19 95 AT

2:45 O'CLOCK P.M. AND RECORDED IN LIBER 6 OF LC RECORDS

ON PAGE 364

Handwritten signature of Mark J. Pisoni, Deputy Register of Deeds

Register of Deeds Stamp & File Number

4. Lot No. , Recorded Plat
5. Private Claims

Section Corner 24, 19, 25, 30, T43N, R32W

I, Gary L. Pisoni, in a field survey on September 6, 1994, do hereby certify that under requirements of P.A. 74, Michigan P.A. of 1970, the corner points mentioned in lines 1 and 2 above were in conformance with regulations and rules therefore as required in the current manual of survey instructions of the United States Department of the Interior, Bureau of Land Management or by a decree of a Court of Law and/or that the corner points mentioned in lines 3, 4 and 5 above were in conformance with the rules of the Michigan Board of Land Surveyors or by a Decree of a Court of Law; established, re-established, monumented, re-monumented, recovered, found as expressed below:

NOTE: Not more than 4 corners, all in the same town and range, may be recorded on this certificate.

Grid table with columns A-M and rows 2-13, containing numbers 1-36.

A. Description of original monument and accessories and/or subsequent restoration:

Original corner established by Austin Burt, U.S Deputy Surveyor in 1846, Original corner: Sugar Post Original bearing trees:

Table listing bearing trees: Lynn (22" S 50 E, 17 links), Yellow Birch (18" N 57 W, 17 links), Hemlock (24" N 40 E, 13 links).

B. Description of corner evidence found and/or method applied in restoring or reestablishing corner:

No evidence of original corner or bearing tree remains. Arthur O. Enger RLS for the DNR found a 1" dia. iron bar encased in concrete on October 31, 1968, set by an unknown surveyor. Mr. Enger recorded this corner in Liber 2, Page 519. Found the iron bar encased in concrete, set an aluminum pipe monument on top of iron bar. Aluminum pipe monument described below and is 2" below road bed surface.

This corner is accepted as the best available evidence of the position of the original corner.


County Record Research on file with County Representative office.

PEER GROUP APPROVED: Iron Surveyors County Representative

C. Description of monument for corner and accessories established to perpetuate locating the position of the corner: A.P. 11-03-94

At the corner position, I set a 2" diameter by 16" long aluminum pipe monument encased in concrete with a 3" cast aluminum cap, stamped to read: Iron County Remonumentation, T43N, R33W - R32W, S-24, S-19, S-25, S-30, 1994, RLS- 27457 from which I established the following new blazed and scribed bearing trees: (all measurements taken to a nail in side of tree)

Table listing monument bearings: Existing Balsam (10" N 17 E, 49.28 feet), Balsam (10" S 39 E, 46.21 feet), Utility Pole #87-24360 (N 37 W, 59.34 feet), New Utility Pole #92-21001 (S 89 W, 35.84 feet), Steel Sign Post (6' N 39 E, 30.55 feet).

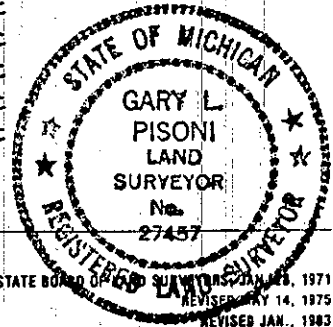

Signed by Gary L. Pisoni Date 1-9-95

Surveyor's Michigan License No. 27457